

SCALE
1" = 10'

SOIL SAMPLING PLAN #10

BRIDGE #4 - WEST ABUTMENT

STAGE 2 EXCAVATION +/- 4000 CY


TOTAL OF 4 COMPOSITE + 4 GEAR SAMPLERS

SHEET 1 OF 2
Volume Calculation

SAMPLING NOTES:

1. FOUR 5-PART COMPOSITE SAMPLE WILL BE TAKEN FROM BRIDGE 4 WEST ABUTMENT EXCAVATION VOLUME. EQUATING TO APPROXIMATELY ONE 5-PART COMPOSITE PER 1000 CY.
2. SAMPLING TO BE PERFORMED BY AQUA-PRO TECH LABORATORIES FIELD TECH.
3. SAMPLING TECHNICIAN SHALL USE A STAINLESS STEEL SAMPLING SPATULA THAT WILL BE DECONTAMINATED BEFORE SAMPLING AND IN BETWEEN SAMPLING AT EACH COMPOSITE AREA OR USE DURABLE TEFLON SPATULAS.
4. MATERIAL WILL BE EXCAVATED VIA AN EXCAVATOR - PC400 OR SIMILAR. SAMPLING TECHNICIAN WILL THEN TAKE A SAMPLE FROM THE MATERIAL WITHIN THE EXCAVATOR'S BUCKET IN ACCORDANCE WITH NOTE #3.

Soil Sampling Plan #10
 Bridge #4 - West Abutment
 Stage 2 Excavation +/- 4,000 CY
 Total of 4 Composite and 4 Grab Samples

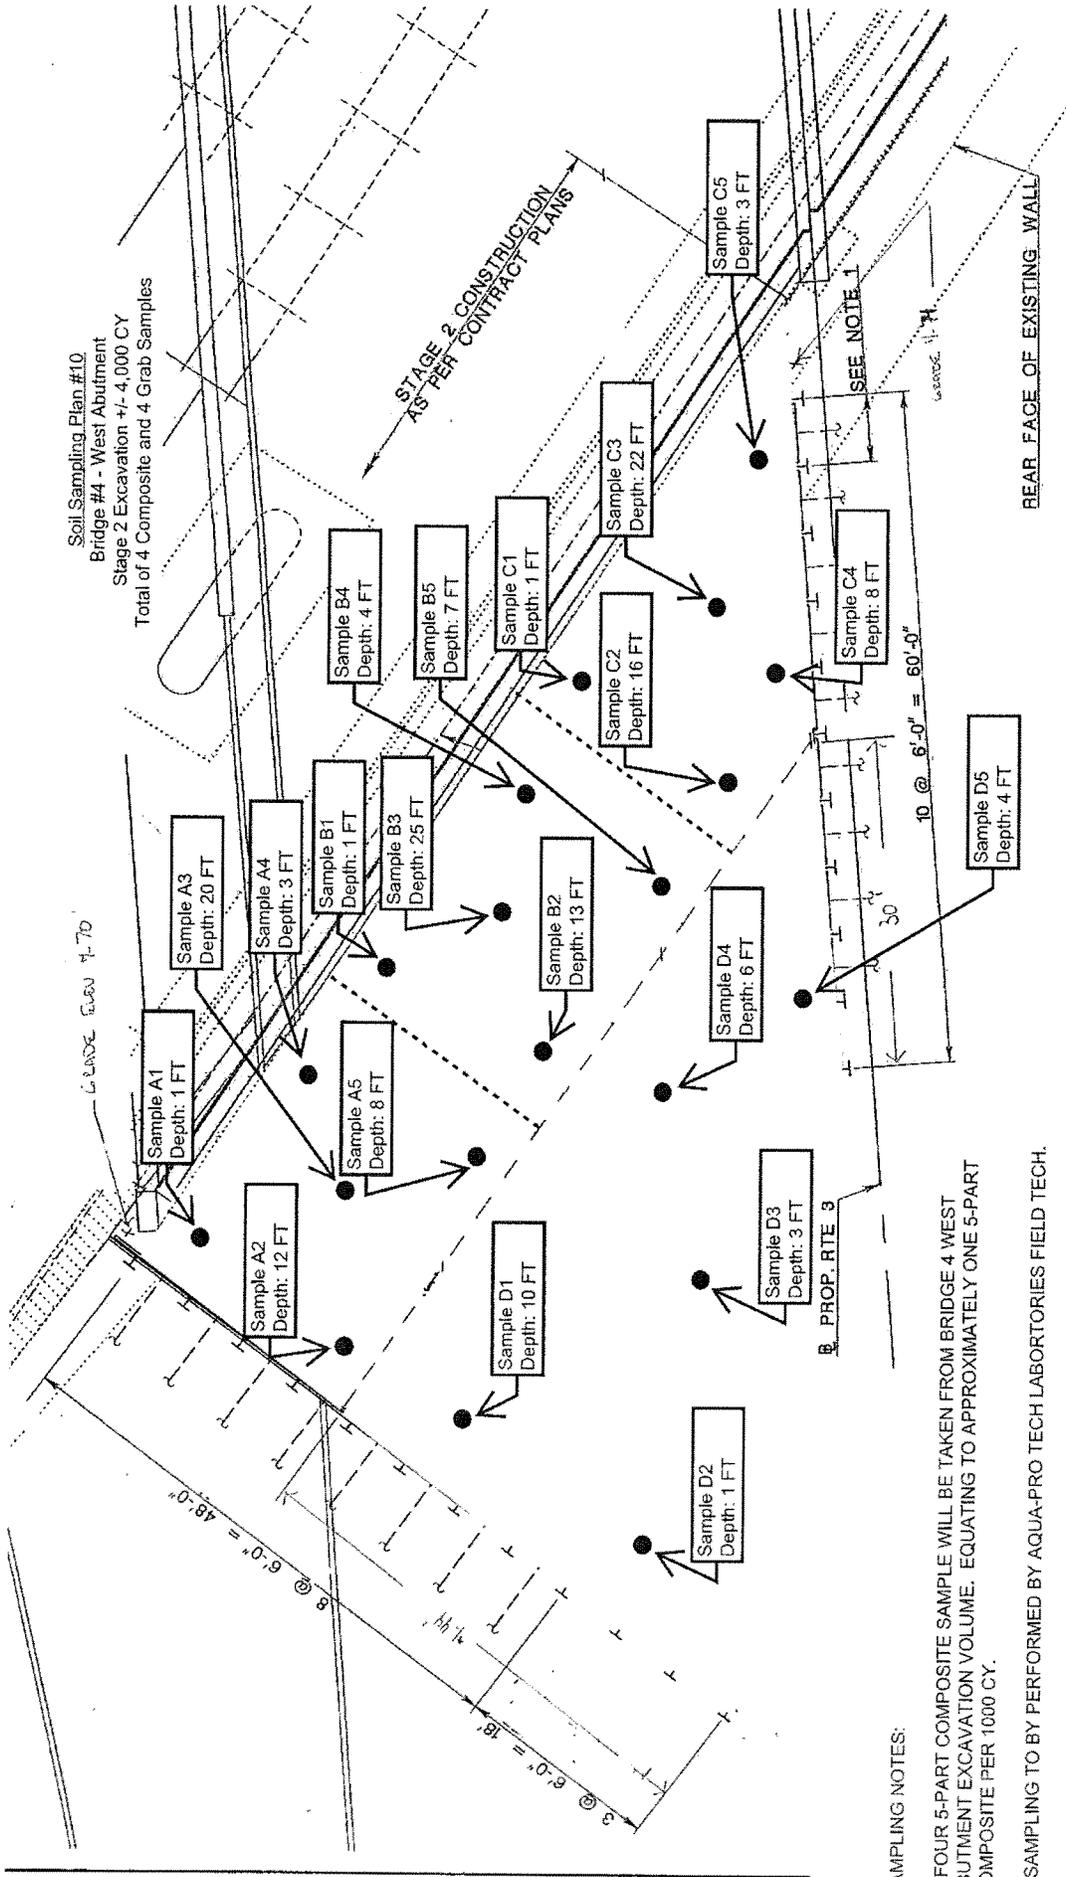

Scale
 1" = 10'

SAMPLING NOTES:

1. FOUR 5-PART COMPOSITE SAMPLE WILL BE TAKEN FROM BRIDGE 4 WEST ABUTMENT EXCAVATION VOLUME. EQUATING TO APPROXIMATELY ONE 5-PART COMPOSITE PER 1000 CY.
2. SAMPLING TO BY PERFORMED BY AQUA-PRO TECH LABORATORIES FIELD TECH.
3. SAMPLING TECHNICIAN SHALL USE A STAINLESS STEEL SAMPLING SPATULA THAT WILL BE DECONTAMINATED BEFORE SAMPLING AND INBETWEEN SAMPLING AT EACH COMPOSITE AREA OR USE DURABLE TEFLON SPATULAS.
4. MATERIAL WILL BE EXCAVATED VIA AN EXCAVATOR - PC400 OR SIMILAR. SAMPLING TECHNICIAN WILL THEN TAKE A SAMPLE FROM THE MATERIAL WITHIN THE EXCAVATOR'S BUCKET IN ACCORDANCE WITH NOTE #3.



RRS Home | Logout | Detailed Report | Creamer-Sanzari Friday, August 10, 2012

Order Information Creamer-Sanzari APL Order ID : 12080180 Site Name : Rt. 3 Clifton 7003217 Date to Lab : 8/6/2012 2:48:00 PM	Samples List <table border="1"> <thead> <tr> <th>Field ID</th> <th>Lab ID</th> <th>Matrix</th> </tr> </thead> <tbody> <tr><td>Rt. 3, bridge 4 - A1-5</td><td>12080180-001</td><td>Soil</td></tr> <tr><td>Rt. 3, bridge 4 - B1-5</td><td>12080180-002</td><td>Soil</td></tr> <tr><td>Rt. 3, bridge 4 - C1-5</td><td>12080180-003</td><td>Soil</td></tr> <tr><td>Rt. 3, bridge 4 - D1-5</td><td>12080180-004</td><td>Soil</td></tr> <tr><td>Rt. 3, Bridge 4 - A1</td><td>12080180-005</td><td>Soil</td></tr> <tr><td>Rt. 3, Bridge 4 - B1</td><td>12080180-006</td><td>Soil</td></tr> <tr><td>Rt. 3, Bridge 4 - C1</td><td>12080180-007</td><td>Soil</td></tr> <tr><td>Rt. 3, Bridge 4 - D2</td><td>12080180-008</td><td>Soil</td></tr> </tbody> </table>	Field ID	Lab ID	Matrix	Rt. 3, bridge 4 - A1-5	12080180-001	Soil	Rt. 3, bridge 4 - B1-5	12080180-002	Soil	Rt. 3, bridge 4 - C1-5	12080180-003	Soil	Rt. 3, bridge 4 - D1-5	12080180-004	Soil	Rt. 3, Bridge 4 - A1	12080180-005	Soil	Rt. 3, Bridge 4 - B1	12080180-006	Soil	Rt. 3, Bridge 4 - C1	12080180-007	Soil	Rt. 3, Bridge 4 - D2	12080180-008	Soil
Field ID	Lab ID	Matrix																										
Rt. 3, bridge 4 - A1-5	12080180-001	Soil																										
Rt. 3, bridge 4 - B1-5	12080180-002	Soil																										
Rt. 3, bridge 4 - C1-5	12080180-003	Soil																										
Rt. 3, bridge 4 - D1-5	12080180-004	Soil																										
Rt. 3, Bridge 4 - A1	12080180-005	Soil																										
Rt. 3, Bridge 4 - B1	12080180-006	Soil																										
Rt. 3, Bridge 4 - C1	12080180-007	Soil																										
Rt. 3, Bridge 4 - D2	12080180-008	Soil																										

Printing Options Turning Page Breaks on prints each sample on a new page. <input checked="" type="checkbox"/> Page Breaks On Turning Page Breaks off prints the report on the minimum number of pages.
--

Rt. 3, bridge 4 - A1-5		12080180-001	8/6/2012, 11:24:00 AM		Soil - SRS Limits		
Click here to request additional or contingent analyses for this Sample ID.							
Test	Method	Date Posted	MDL #	Result	Units	Limit	
Total EPH	NJDEP-EPH	8/9/2012	-	<22	mg/Kg	-	
Percent Solids	Gravimetric	8/7/2012	-	94.5	%	-	
C10-C12 Aromatics	NJDEP-EPH	8/9/2012	-	NA	mg/Kg	-	
C12-C16 Aliphatics	NJDEP-EPH	8/9/2012	-	NA	mg/Kg	-	
C12-C16 Aromatics	NJDEP-EPH	8/9/2012	-	NA	mg/Kg	-	
C16-C21 Aliphatics	NJDEP-EPH	8/9/2012	-	NA	mg/Kg	-	
C16-C21 Aromatics	NJDEP-EPH	8/9/2012	-	NA	mg/Kg	-	
C21-C36 Aromatics	NJDEP-EPH	8/9/2012	-	NA	mg/Kg	-	
C21-C40 Aliphatics	NJDEP-EPH	8/9/2012	-	NA	mg/Kg	-	
C9-C12 Aliphatics	NJDEP-EPH	8/9/2012	-	NA	mg/Kg	-	
Pesticides	SW 846 8081A	8/9/2012	-	Results Listed Below	-	-	
Compound	Qualifier	Type	MDL	Dilution	Result	Units	Limit
alpha-BHC	U	A	0.281	1	ND	µg/kg	100
beta-BHC	U	A	0.274	1	ND	µg/kg	400
gamma-BHC (Lindane)	U	A	0.217	1	ND	µg/kg	400
delta-BHC	U	A	0.211	1	ND	µg/kg	-
Aldrin	U	A	0.234	1	ND	µg/kg	40
Heptachlor	U	A	0.323	1	ND	µg/kg	100
Heptachlor Epoxide	U	A	0.353	1	ND	µg/kg	70
Endosulfan I	U	A	0.392	1	ND	µg/kg	-
Endosulfan II	U	A	0.263	1	ND	µg/kg	-
4,4'-DDE	U	A	0.248	1	ND	µg/kg	2000
4,4'-DDD	U	A	0.157	1	ND	µg/kg	3000
4,4'-DDT	U	A	0.27	1	ND	µg/kg	2000
Dieldrin	U	A	0.283	1	ND	µg/kg	40
Endrin	U	A	0.273	1	ND	µg/kg	23000
Endrin Aldehyde	U	A	0.584	1	ND	µg/kg	-
Endrin Ketone	U	A	0.253	1	ND	µg/kg	-

Endosulfan Sulfate	U	A	0.249	1	ND	µg/kg	470000
Methoxychlor	U	A	0.317	1	ND	µg/kg	390000
Chlordane	U	A	0.541	1	ND	µg/kg	200
Toxaphene	U	A	3.83	1	ND	µg/kg	600
Semivolatile Organics	SW 846 8270C	8/9/2012	-	-	Results Listed Below	-	-
Compound	Qualifier	Type	MDL	Dilution	Result	Units	Limit
Pyridine	U	A	202	1	ND	ug/kg	-
n-Nitroso-dimethylamine	U	A	317	1	ND	ug/kg	-
Benzaldehyde	U	A	105	1	ND	ug/kg	-
Aniline	U	A	15.5	1	ND	ug/kg	-
Phenol	U	A	15.5	1	ND	ug/kg	-
bis(2-Chloroethyl)ether	U	A	21.9	1	ND	ug/kg	-
2-Chlorophenol	U	A	14.8	1	ND	ug/kg	-
1,3-Dichlorobenzene	U	A	23.2	1	ND	ug/kg	-
1,4-Dichlorobenzene	U	A	26.8	1	ND	ug/kg	-
Benzyl Alcohol	U	A	489	1	ND	ug/kg	-
1,2-Dichlorobenzene	U	A	16.2	1	ND	ug/kg	-
2-Methylphenol	U	A	16.2	1	ND	ug/kg	-
bis(2-Chloroisopropyl)ether	U	A	17.6	1	ND	ug/kg	-
Acetophenone	U	A	93.1	1	ND	ug/kg	-
3+4-Methylphenol	U	A	26.8	1	ND	ug/kg	-
n-Nitroso-di-n-propylamine	U	A	31.0	1	ND	ug/kg	-
Hexachloroethane	U	A	19.8	1	ND	ug/kg	-
Nitrobenzene	U	A	14.1	1	ND	ug/kg	-
Isophorone	U	A	14.8	1	ND	ug/kg	-
2-Nitrophenol	U	A	150	1	ND	ug/kg	-
2,4-Dimethylphenol	U	A	19.8	1	ND	ug/kg	-
bis(2-Chloroethoxy)methane	U	A	24.0	1	ND	ug/kg	-
2,4-Dichlorophenol	U	A	43.7	1	ND	ug/kg	-
Benzoic Acid	U	A	447	1	ND	ug/kg	-
1,2,4-Trichlorobenzene	U	A	24.7	1	ND	ug/kg	-
Naphthalene	U	A	15.5	1	ND	ug/kg	-
2,6-Dichlorophenol	U	A	18.3	1	ND	ug/kg	-
4-Chloroaniline	U	A	21.2	1	ND	ug/kg	-
Hexachlorobutadiene	U	A	20.5	1	ND	ug/kg	-
Caprolactam	U	A	64.2	1	ND	ug/kg	-
4-Chloro-3-methylphenol	U	A	24.7	1	ND	ug/kg	-
2-Methylnaphthalene	U	A	18.3	1	ND	ug/kg	-
Hexachlorocyclopentadiene	U	A	289	1	ND	ug/kg	-
1,2,4,5-Tetrachlorobenzene	U	A	18.3	1	ND	ug/kg	-
2,4,6-Trichlorophenol	U	A	18.3	1	ND	ug/kg	-
2,4,5-Trichlorophenol	U	A	36.0	1	ND	ug/kg	-
Biphenyl	U	A	69.1	1	ND	ug/kg	-
2-Chloronaphthalene	U	A	14.1	1	ND	ug/kg	-
2-Nitroaniline	U	A	7.76	1	ND	ug/kg	-
Dimethylphthalate		A	20.5	1	211	ug/kg	-
Acenaphthylene	U	A	11.3	1	ND	ug/kg	-
2,6-Dinitrotoluene	U	A	29.6	1	ND	ug/kg	-
3-Nitroaniline	U	A	344	1	ND	ug/kg	-
Acenaphthene	U	A	14.1	1	ND	ug/kg	-
2,4-Dinitrophenol	U	A	27.5	1	ND	ug/kg	-
Dibenzofuran	U	A	15.5	1	ND	ug/kg	-

4-Nitrophenol	U	A	92.4	1	ND	ug/kg	-
2,4-Dinitrotoluene	U	A	27.5	1	ND	ug/kg	-
2,3,4,6-Tetrachlorophenol	U	A	459	1	ND	ug/kg	-
Fluorene	U	A	10.6	1	ND	ug/kg	-
Diethylphthalate	J	A	762	1	39.2	ug/kg	49000000
4-Chlorophenyl phenyl ether	U	A	19.0	1	ND	ug/kg	-
4-Nitroaniline	U	A	193	1	ND	ug/kg	-
4,6-Dinitro-2-methylphenol	U	A	200	1	ND	ug/kg	-
n-Nitrosodiphenylamine	U	A	15.5	1	ND	ug/kg	-
1,2-Diphenylhydrazine	U	A	12.0	1	ND	ug/kg	-
4-Bromophenyl-phenyl ether	U	A	22.6	1	ND	ug/kg	-
Hexachlorobenzene	U	A	31.7	1	ND	ug/kg	-
Atrazine	U	A	57.8	1	ND	ug/kg	-
Pentachlorophenol	U	A	150	1	ND	ug/kg	-
Phenanthrene	U	A	5.64	1	ND	ug/kg	-
Anthracene	U	A	9.88	1	ND	ug/kg	-
Carbazole	U	A	21.9	1	ND	ug/kg	-
Di-n-butylphthalate	U	A	33.9	1	ND	ug/kg	-
Fluoranthene	U	A	17.6	1	ND	ug/kg	-
Benzidine	U	A	331	1	ND	ug/kg	-
Pyrene	U	A	9.88	1	ND	ug/kg	-
Butylbenzylphthalate		A	13.4	1	69.4	ug/kg	1200000
Benzo(a)anthracene	U	A	12.0	1	ND	ug/kg	-
3,3'-Dichlorobenzidine	U	A	185	1	ND	ug/kg	-
Chrysene	U	A	14.1	1	ND	ug/kg	-
bis(2-Ethylhexyl)phthalate	J	A	241	1	59.8	ug/kg	35000
Di-n-octylphthalate	U	A	21.9	1	ND	ug/kg	-
Benzo(b)fluoranthene	U	A	24.0	1	ND	ug/kg	-
Benzo(k)fluoranthene	U	A	19.0	1	ND	ug/kg	-
Benzo(a)pyrene	U	A	13.4	1	ND	ug/kg	-
Indeno(1,2,3-cd)pyrene	U	A	9.17	1	ND	ug/kg	-
Dibenzo(a,h)anthracene	U	A	11.3	1	ND	ug/kg	-
Benzo(g,h,i)perylene	U	A	18.3	1	ND	ug/kg	-
No TICs Detected		T			0	ug	-

No TICs Detected/Reported for this test.

PCBs	SW 846 8082	8/9/2012	-	Results Listed Below	-	-	
Compound	Qualifier	Type	MDL	Dilution	Result	Units	Limit
Aroclor 1016	U	A	2.5	1	ND	µg/kg	200
Aroclor 1221	U	A	3.15	1	ND	µg/kg	200
Aroclor 1232	U	A	3.71	1	ND	µg/kg	200
Aroclor 1242	U	A	1.71	1	ND	µg/kg	200
Aroclor 1248	U	A	1.18	1	ND	µg/kg	200
Aroclor 1254	U	A	2.63	1	ND	µg/kg	200
Aroclor 1260	U	A	2.53	1	ND	µg/kg	200
Aroclor 1262	U	A	2.58	1	ND	µg/kg	200
Aroclor 1268	U	A	1.91	1	ND	µg/kg	200
Cyanide	SW 846 9010B	8/8/2012	-	-	<0.26	mg/Kg	1600
Mercury	SW 846 7471A	8/9/2012	-	-	<0.016	mg/kg	23
Beryllium	SW 846 6010B	8/9/2012	-	-	0.0411	mg/kg	15
Cadmium	SW 846 6010B	8/9/2012	-	-	<0.06	mg/kg	78
Nickel	SW 846 6010B	8/9/2012	-	-	7.88	mg/kg	1600
Arsenic	SW 846 6010B	8/9/2012	-	-	0.649	mg/kg	19

Cobalt	SW 846 6010B	8/9/2012	-	4.18	mg/kg	1600
Lead	SW 846 6010B	8/9/2012	-	4.91	mg/kg	400
Manganese	SW 846 6010B	8/9/2012	-	276	mg/kg	11000
Chromium	SW 846 6010B	8/9/2012	-	8.51	mg/Kg	-
Copper	SW 846 6010B	8/9/2012	-	5.33	mg/kg	3100
Silver	SW 846 6010B	8/9/2012	-	<0.59	mg/Kg	390
Thallium	SW 846 6010B	8/9/2012	-	<0.59	mg/kg	5
Antimony	SW 846 6010B	8/9/2012	-	<0.59	mg/kg	31
Barium	SW 846 6010B	8/9/2012	-	28.1	mg/kg	16000
Vanadium	SW 846 6010B	8/9/2012	-	12.6	mg/kg	78
Selenium	SW 846 6010B	8/9/2012	-	<0.74	mg/kg	390
Zinc	SW 846 6010B	8/9/2012	-	16.7	mg/kg	23000
Iron	SW 846 6010B	8/9/2012	-	11100	mg/kg	-
Aluminum	SW 846 6010B	8/9/2012	-	3880	mg/kg	78000
Calcium	SW 846 6010B	8/9/2012	-	1060	mg/kg	-
Magnesium	SW 846 6010B	8/9/2012	-	1430	mg/kg	-
Sodium	SW 846 6010B	8/9/2012	-	271	mg/kg	-
Potassium	SW 846 6010B	8/9/2012	-	646	mg/kg	-

Rt. 3, bridge 4 - B1-5		12080180-002	8/6/2012, 10:47:00 AM		Soil - SRS Limits		
Click here to request additional or contingent analyses for this Sample ID.							
Test	Method	Date Posted	MDL #	Result	Units	Limit	
Total EPH	NJDEP-EPH	8/9/2012	-	<22	mg/Kg	-	
Percent Solids	Gravimetric	8/7/2012	-	94.4	%	-	
C10-C12 Aromatics	NJDEP-EPH	8/9/2012	-	NA	mg/Kg	-	
C12-C16 Aliphatics	NJDEP-EPH	8/9/2012	-	NA	mg/Kg	-	
C12-C16 Aromatics	NJDEP-EPH	8/9/2012	-	NA	mg/Kg	-	
C16-C21 Aliphatics	NJDEP-EPH	8/9/2012	-	NA	mg/Kg	-	
C16-C21 Aromatics	NJDEP-EPH	8/9/2012	-	NA	mg/Kg	-	
C21-C36 Aromatics	NJDEP-EPH	8/9/2012	-	NA	mg/Kg	-	
C21-C40 Aliphatics	NJDEP-EPH	8/9/2012	-	NA	mg/Kg	-	
C9-C12 Aliphatics	NJDEP-EPH	8/9/2012	-	NA	mg/Kg	-	
Pesticides	SW 846 8081A	8/9/2012	-	Results Listed Below	-	-	
Compound	Qualifier	Type	MDL	Dilution	Result	Units	Limit
alpha-BHC	U	A	0.261	1	ND	µg/kg	100
beta-BHC	U	A	0.274	1	ND	µg/kg	400
gamma-BHC (Lindane)	U	A	0.218	1	ND	µg/kg	400
delta-BHC	U	A	0.211	1	ND	µg/kg	-
Aldrin	U	A	0.234	1	ND	µg/kg	40
Heptachlor	U	A	0.323	1	ND	µg/kg	100
Heptachlor Epoxide	U	A	0.354	1	ND	µg/kg	70
Endosulfan I	U	A	0.392	1	ND	µg/kg	-
Endosulfan II	U	A	0.264	1	ND	µg/kg	-
4,4'-DDE	U	A	0.248	1	ND	µg/kg	2000
4,4'-DDD	U	A	0.157	1	ND	µg/kg	3000
4,4'-DDT	U	A	0.27	1	ND	µg/kg	2000
Dieldrin	U	A	0.284	1	ND	µg/kg	40
Endrin	U	A	0.273	1	ND	µg/kg	23000
Endrin Aldehyde	U	A	0.584	1	ND	µg/kg	-
Endrin Ketone	U	A	0.253	1	ND	µg/kg	-

Endosulfan Sulfate	U	A	0.25	1	ND	µg/kg	470000
Methoxychlor	U	A	0.318	1	ND	µg/kg	390000
Chlordane	U	A	0.542	1	ND	µg/kg	200
Toxaphene	U	A	3.83	1	ND	µg/kg	600

Semivolatile Organics SW 846 8270C 8/9/2012 - Results Listed Below -

Compound	Qualifier	Type	MDL	Dilution	Result	Units	Limit
Pyridine	U	A	203	1	ND	ug/kg	-
n-Nitroso-dimethylamine	U	A	318	1	ND	ug/kg	-
Benzaldehyde	U	A	105	1	ND	ug/kg	-
Aniline	U	A	15.5	1	ND	ug/kg	-
Phenol	U	A	15.5	1	ND	ug/kg	-
bis(2-Chloroethyl)ether	U	A	21.9	1	ND	ug/kg	-
2-Chlorophenol	U	A	14.8	1	ND	ug/kg	-
1,3-Dichlorobenzene	U	A	21.2	1	ND	ug/kg	-
1,4-Dichlorobenzene	U	A	26.8	1	ND	ug/kg	-
Benzyl Alcohol	U	A	489	1	ND	ug/kg	-
1,2-Dichlorobenzene	U	A	16.2	1	ND	ug/kg	-
2-Methylphenol	U	A	16.2	1	ND	ug/kg	-
bis(2-Chloroisopropyl)ether	U	A	17.7	1	ND	ug/kg	-
Acetophenone	U	A	93.2	1	ND	ug/kg	-
3+4-Methylphenol	U	A	26.8	1	ND	ug/kg	-
n-Nitroso-di-n-propylamine	U	A	31.1	1	ND	ug/kg	-
Hexachloroethane	U	A	19.8	1	ND	ug/kg	-
Nitrobenzene	U	A	14.1	1	ND	ug/kg	-
Isophorone	U	A	14.8	1	ND	ug/kg	-
2-Nitrophenol	U	A	150	1	ND	ug/kg	-
2,4-Dimethylphenol	U	A	19.8	1	ND	ug/kg	-
bis(2-Chloroethoxy)methane	U	A	24.0	1	ND	ug/kg	-
2,4-Dichlorophenol	U	A	43.8	1	ND	ug/kg	-
Benzoic Acid	U	A	448	1	ND	ug/kg	-
1,2,4-Trichlorobenzene	U	A	24.7	1	ND	ug/kg	-
Naphthalene	U	A	15.5	1	ND	ug/kg	-
2,6-Dichlorophenol	U	A	18.4	1	ND	ug/kg	-
4-Chloroaniline	U	A	21.2	1	ND	ug/kg	-
Hexachlorobutadiene	U	A	20.5	1	ND	ug/kg	-
Caprolactam	U	A	64.3	1	ND	ug/kg	-
4-Chloro-3-methylphenol	U	A	24.7	1	ND	ug/kg	-
2-Methylnaphthalene	U	A	18.4	1	ND	ug/kg	-
Hexachlorocyclopentadiene	U	A	290	1	ND	ug/kg	-
1,2,4,5-Tetrachlorobenzene	U	A	18.4	1	ND	ug/kg	-
2,4,6-Trichlorophenol	U	A	18.4	1	ND	ug/kg	-
2,4,5-Trichlorophenol	U	A	36.0	1	ND	ug/kg	-
Biphenyl	U	A	69.2	1	ND	ug/kg	-
2-Chloronaphthalene	U	A	14.1	1	ND	ug/kg	-
2-Nitroaniline	U	A	7.77	1	ND	ug/kg	-
Dimethylphthalate		A	20.5	1	223	ug/kg	-
Acenaphthylene	U	A	11.3	1	ND	ug/kg	-
2,6-Dinitrotoluene	U	A	29.7	1	ND	ug/kg	-
3-Nitroaniline	U	A	345	1	ND	ug/kg	-
Acenaphthene	U	A	14.1	1	ND	ug/kg	-
2,4-Dinitrophenol	U	A	27.5	1	ND	ug/kg	-
Dibenzofuran	U	A	15.5	1	ND	ug/kg	-

4-Nitrophenol	U	A	92.5	1	ND	ug/kg	-
2,4-Dinitrotoluene	U	A	27.5	1	ND	ug/kg	-
2,3,4,6-Tetrachlorophenol	U	A	460	1	ND	ug/kg	-
Fluorene	U	A	10.6	1	ND	ug/kg	-
Diethylphthalate	U	A	763	1	ND	ug/kg	-
4-Chlorophenyl phenyl ether	U	A	19.1	1	ND	ug/kg	-
4-Nitroaniline	U	A	194	1	ND	ug/kg	-
4,6-Dinitro-2-methylphenol	U	A	200	1	ND	ug/kg	-
n-Nitrosodiphenylamine	U	A	15.5	1	ND	ug/kg	-
1,2-Diphenylhydrazine	U	A	12.0	1	ND	ug/kg	-
4-Bromophenyl-phenyl ether	U	A	22.6	1	ND	ug/kg	-
Hexachlorobenzene	U	A	31.8	1	ND	ug/kg	-
Atrazine	U	A	57.9	1	ND	ug/kg	-
Pentachlorophenol	U	A	150	1	ND	ug/kg	-
Phenanthrene	U	A	5.65	1	ND	ug/kg	-
Anthracene	U	A	9.89	1	ND	ug/kg	-
Carbazole	U	A	21.9	1	ND	ug/kg	-
Di-n-butylphthalate	U	A	33.9	1	ND	ug/kg	-
Fluoranthene	U	A	17.7	1	ND	ug/kg	-
Benzidine	U	A	331	1	ND	ug/kg	-
Pyrene	U	A	9.89	1	ND	ug/kg	-
Butylbenzylphthalate	U	A	13.4	1	ND	ug/kg	-
Benzo(a)anthracene	U	A	12.0	1	ND	ug/kg	-
3,3'-Dichlorobenzidine	U	A	185	1	ND	ug/kg	-
Chrysene	U	A	14.1	1	ND	ug/kg	-
bis(2-Ethylhexyl)phthalate	U	A	242	1	ND	ug/kg	-
Di-n-octylphthalate	U	A	21.9	1	ND	ug/kg	-
Benzo(b)fluoranthene	U	A	24.0	1	ND	ug/kg	-
Benzo(k)fluoranthene	U	A	19.1	1	ND	ug/kg	-
Benzo(a)pyrene	U	A	13.4	1	ND	ug/kg	-
Indeno(1,2,3-cd)pyrene	U	A	9.18	1	ND	ug/kg	-
Dibenzo(a,h)anthracene	U	A	11.3	1	ND	ug/kg	-
Benzo(g,h,i)perylene	U	A	18.4	1	ND	ug/kg	-
Phosphonic acid, dioctadecyl ester	JN	T			740	ug/kg	-
TIC (Total)	-	T (Sum)	-	-	740	ug/kg	-
PCBs	SW 846 8082	8/9/2012	-	-	Results Listed Below	-	-
Compound	Qualifier	Type	MDL	Dilution	Result	Units	Limit
Aroclor 1016	U	A	2.5	1	ND	µg/kg	200
Aroclor 1221	U	A	3.15	1	ND	µg/kg	200
Aroclor 1232	U	A	3.71	1	ND	µg/kg	200
Aroclor 1242	U	A	1.71	1	ND	µg/kg	200
Aroclor 1248	U	A	1.18	1	ND	µg/kg	200
Aroclor 1254	U	A	2.64	1	ND	µg/kg	200
Aroclor 1260	U	A	2.53	1	ND	µg/kg	200
Aroclor 1262	U	A	2.58	1	ND	µg/kg	200
Aroclor 1268	U	A	1.91	1	ND	µg/kg	200
Cyanide	SW 846 9010B	8/8/2012	-	-	<0.26	mg/Kg	1600
Mercury	SW 846 7471A	8/9/2012	-	-	<0.016	mg/kg	23
Beryllium	SW 846 6010B	8/9/2012	-	-	<0.03	mg/kg	16
Cadmium	SW 846 6010B	8/9/2012	-	-	<0.06	mg/kg	78
Nickel	SW 846 6010B	8/9/2012	-	-	7.48	mg/kg	1600
Arsenic	SW 846 6010B	8/9/2012	-	-	0.672	mg/kg	19

Cobalt	SW 846 6010B	8/9/2012	-	4.08	mg/kg	1600
Lead	SW 846 6010B	8/9/2012	-	4.28	mg/kg	400
Manganese	SW 846 6010B	8/9/2012	-	331	mg/kg	11000
Chromium	SW 846 6010B	8/9/2012	-	7.28	mg/Kg	-
Copper	SW 846 6010B	8/9/2012	-	4.48	mg/kg	3100
Silver	SW 846 6010B	8/9/2012	-	<0.58	mg/Kg	390
Thallium	SW 846 6010B	8/9/2012	-	<0.58	mg/kg	5
Antimony	SW 846 6010B	8/9/2012	-	<0.58	mg/kg	31
Barium	SW 846 6010B	8/9/2012	-	29.4	mg/kg	16000
Vanadium	SW 846 6010B	8/9/2012	-	12.2	mg/kg	78
Selenium	SW 846 6010B	8/9/2012	-	<0.73	mg/kg	390
Zinc	SW 846 6010B	8/9/2012	-	14.8	mg/kg	23000
Iron	SW 846 6010B	8/9/2012	-	10400	mg/kg	-
Aluminum	SW 846 6010B	8/9/2012	-	3550	mg/kg	78000
Calcium	SW 846 6010B	8/9/2012	-	1530	mg/kg	-
Magnesium	SW 846 6010B	8/9/2012	-	1350	mg/kg	-
Sodium	SW 846 6010B	8/9/2012	-	193	mg/kg	-
Potassium	SW 846 6010B	8/9/2012	-	491	mg/kg	-

Rt. 3, bridge 4 - C1-5		12080180-003	8/6/2012, 9:57:00 AM		Soil - SRS Limits		
Click here to request additional or contingent analyses for this Sample ID.							
Test	Method	Date Posted	MDL #	Result	Units	Limit	
Total EPH	NJDEP-EPH	8/9/2012	-	<22	mg/Kg	-	
Percent Solids	Gravimetric	8/7/2012	-	93	%	-	
C10-C12 Aromatics	NJDEP-EPH	8/9/2012	-	NA	mg/Kg	-	
C12-C16 Aliphatics	NJDEP-EPH	8/9/2012	-	NA	mg/Kg	-	
C12-C16 Aromatics	NJDEP-EPH	8/9/2012	-	NA	mg/Kg	-	
C16-C21 Aliphatics	NJDEP-EPH	8/9/2012	-	NA	mg/Kg	-	
C16-C21 Aromatics	NJDEP-EPH	8/9/2012	-	NA	mg/Kg	-	
C21-C36 Aromatics	NJDEP-EPH	8/9/2012	-	NA	mg/Kg	-	
C21-C40 Aliphatics	NJDEP-EPH	8/9/2012	-	NA	mg/Kg	-	
C9-C12 Aliphatics	NJDEP-EPH	8/9/2012	-	NA	mg/Kg	-	
Pesticides	SW 846 8081A	8/9/2012	-	Results Listed Below	-	-	
Compound	Qualifier	Type	MDL	Dilution	Result	Units	Limit
alpha-BHC	U	A	0.285	1	ND	µg/kg	100
beta-BHC	U	A	0.278	1	ND	µg/kg	400
gamma-BHC (Lindane)	U	A	0.221	1	ND	µg/kg	400
delta-BHC	U	A	0.214	1	ND	µg/kg	-
Aldrin	U	A	0.238	1	ND	µg/kg	40
Heptachlor	U	A	0.328	1	ND	µg/kg	100
Heptachlor Epoxide	U	A	0.359	1	ND	µg/kg	70
Endosulfan I	U	A	0.398	1	ND	µg/kg	-
Endosulfan II	U	A	0.268	1	ND	µg/kg	-
4,4'-DDE	U	A	0.252	1	ND	µg/kg	2000
4,4'-DDD	U	A	0.16	1	ND	µg/kg	3000
4,4'-DDT	U	A	0.274	1	ND	µg/kg	2000
Dieldrin	U	A	0.288	1	ND	µg/kg	40
Endrin	U	A	0.277	1	ND	µg/kg	23000
Endrin Aldehyde	U	A	0.593	1	ND	µg/kg	-
Endrin Ketone	U	A	0.257	1	ND	µg/kg	-

Endosulfan Sulfate	U	A	0.253	1	ND	µg/kg	470000
Methoxychlor	U	A	0.322	1	ND	µg/kg	390000
Chlordane	U	A	0.55	1	ND	µg/kg	200
Toxaphene	U	A	3.89	1	ND	µg/kg	600

Semivolatile Organics SW 846 8270C 8/9/2012 - Results Listed Below - -

Compound	Qualifier	Type	MDL	Dilution	Result	Units	Limit
Pyridine	U	A	206	1	ND	ug/kg	-
n-Nitroso-dimethylamine	U	A	323	1	ND	ug/kg	-
Benzaldehyde	U	A	107	1	ND	ug/kg	-
Aniline	U	A	15.8	1	ND	ug/kg	-
Phenol	U	A	15.8	1	ND	ug/kg	-
bis(2-Chloroethyl)ether	U	A	22.2	1	ND	ug/kg	-
2-Chlorophenol	U	A	15.1	1	ND	ug/kg	-
1,3-Dichlorobenzene	U	A	21.5	1	ND	ug/kg	-
1,4-Dichlorobenzene	U	A	27.2	1	ND	ug/kg	-
Benzyl Alcohol	U	A	497	1	ND	ug/kg	-
1,2-Dichlorobenzene	U	A	16.5	1	ND	ug/kg	-
2-Methylphenol	U	A	16.5	1	ND	ug/kg	-
bis(2-Chloroisopropyl)ether	U	A	17.9	1	ND	ug/kg	-
Acetophenone	U	A	94.6	1	ND	ug/kg	-
3+4-Methylphenol	U	A	27.2	1	ND	ug/kg	-
n-Nitroso-di-n-propylamine	U	A	31.5	1	ND	ug/kg	-
Hexachloroethane	U	A	20.1	1	ND	ug/kg	-
Nitrobenzene	U	A	14.3	1	ND	ug/kg	-
Isophorone	U	A	15.1	1	ND	ug/kg	-
2-Nitrophenol	U	A	153	1	ND	ug/kg	-
2,4-Dimethylphenol	U	A	20.1	1	ND	ug/kg	-
bis(2-Chloroethoxy)methane	U	A	24.4	1	ND	ug/kg	-
2,4-Dichlorophenol	U	A	44.4	1	ND	ug/kg	-
Benzic Acid	U	A	454	1	ND	ug/kg	-
1,2,4-Trichlorobenzene	U	A	25.1	1	ND	ug/kg	-
Naphthalene	U	A	15.8	1	ND	ug/kg	-
2,6-Dichlorophenol	U	A	18.6	1	ND	ug/kg	-
4-Chloroaniline	U	A	21.5	1	ND	ug/kg	-
Hexachlorobutadiene	U	A	20.8	1	ND	ug/kg	-
Caprolactam	U	A	65.2	1	ND	ug/kg	-
4-Chloro-3-methylphenol	U	A	25.1	1	ND	ug/kg	-
2-Methylnaphthalene	U	A	18.6	1	ND	ug/kg	-
Hexachlorocyclopentadiene	U	A	294	1	ND	ug/kg	-
1,2,4,5-Tetrachlorobenzene	U	A	18.6	1	ND	ug/kg	-
2,4,6-Trichlorophenol	U	A	18.6	1	ND	ug/kg	-
2,4,5-Trichlorophenol	U	A	36.6	1	ND	ug/kg	-
Biphenyl	U	A	70.3	1	ND	ug/kg	-
2-Chloronaphthalene	U	A	14.3	1	ND	ug/kg	-
2-Nitroaniline	U	A	7.89	1	ND	ug/kg	-
Dimethylphthalate		A	20.8	1	223	ug/kg	-
Acenaphthylene	U	A	11.5	1	ND	ug/kg	-
2,6-Dinitrotoluene	U	A	30.1	1	ND	ug/kg	-
3-Nitroaniline	U	A	350	1	ND	ug/kg	-
Acenaphthene	U	A	14.3	1	ND	ug/kg	-
2,4-Dinitrophenol	U	A	28.0	1	ND	ug/kg	-
Dibenzofuran	U	A	15.8	1	ND	ug/kg	-

4-Nitrophenol	U	A	93.9	1	ND	ug/kg	-
2,4-Dinitrotoluene	U	A	28.0	1	ND	ug/kg	-
2,3,4,6-Tetrachlorophenol	U	A	467	1	ND	ug/kg	-
Fluorene	U	A	10.8	1	ND	ug/kg	-
Diethylphthalate	U	A	774	1	ND	ug/kg	-
4-Chlorophenyl phenyl ether	U	A	19.4	1	ND	ug/kg	-
4-Nitroaniline	U	A	196	1	ND	ug/kg	-
4,6-Dinitro-2-methylphenol	U	A	203	1	ND	ug/kg	-
n-Nitrosodiphenylamine	U	A	15.8	1	ND	ug/kg	-
1,2-Diphenylhydrazine	U	A	12.2	1	ND	ug/kg	-
4-Bromophenyl-phenyl ether	U	A	22.9	1	ND	ug/kg	-
Hexachlorobenzene	U	A	32.3	1	ND	ug/kg	-
Atrazine	U	A	58.8	1	ND	ug/kg	-
Pentachlorophenol	U	A	152	1	ND	ug/kg	-
Phenanthrene	U	A	5.73	1	ND	ug/kg	-
Anthracene	U	A	10.0	1	ND	ug/kg	-
Carbazole	U	A	22.2	1	ND	ug/kg	-
Di-n-butylphthalate	U	A	34.4	1	ND	ug/kg	-
Fluoranthene	U	A	17.9	1	ND	ug/kg	-
Benzidine	U	A	336	1	ND	ug/kg	-
Pyrene	U	A	10.0	1	ND	ug/kg	-
Butylbenzylphthalate	U	A	13.6	1	ND	ug/kg	-
Benzo(a)anthracene	U	A	12.2	1	ND	ug/kg	-
3,3'-Dichlorobenzidine	U	A	188	1	ND	ug/kg	-
Chrysene	U	A	14.3	1	ND	ug/kg	-
bis(2-Ethylhexyl)phthalate	U	A	245	1	ND	ug/kg	-
Di-n-octylphthalate	U	A	22.2	1	ND	ug/kg	-
Benzo(b)fluoranthene	U	A	24.4	1	ND	ug/kg	-
Benzo(k)fluoranthene	U	A	19.4	1	ND	ug/kg	-
Benzo(a)pyrene	U	A	13.6	1	ND	ug/kg	-
Indeno(1,2,3-cd)pyrene	U	A	9.32	1	ND	ug/kg	-
Dibenzo(a,h)anthracene	U	A	11.5	1	ND	ug/kg	-
Benzo(g,h,i)perylene	U	A	18.6	1	ND	ug/kg	-
Phosphonic acid, dioctadecyl ester	JN	T	-	-	366	ug/kg	-
TIC (Total)	-	T (Sum)	-	-	366	ug/kg	-

SW 846 8082				8/9/2012		Results Listed Below		
PCBs	Compound	Qualifier	Type	MDL	Dilution	Result	Units	Limit
	Aroclor 1016	U	A	2.54	1	ND	µg/kg	200
	Aroclor 1221	U	A	3.2	1	ND	µg/kg	200
	Aroclor 1232	U	A	3.77	1	ND	µg/kg	200
	Aroclor 1242	U	A	1.74	1	ND	µg/kg	200
	Aroclor 1248	U	A	1.2	1	ND	µg/kg	200
	Aroclor 1254	U	A	2.68	1	ND	µg/kg	200
	Aroclor 1260	U	A	2.57	1	ND	µg/kg	200
	Aroclor 1262	U	A	2.62	1	ND	µg/kg	200
	Aroclor 1268	U	A	1.94	1	ND	µg/kg	200
	Cyanide		SW 846 9010B	8/8/2012	-	<0.27	mg/Kg	1600
	Mercury		SW 846 7471A	8/9/2012	-	<0.014	mg/kg	23
	Beryllium		SW 846 6010B	8/9/2012	-	0.0357	mg/kg	16
	Cadmium		SW 846 6010B	8/9/2012	-	<0.06	mg/kg	78
	Nickel		SW 846 6010B	8/9/2012	-	7.56	mg/kg	1600
	Arsenic		SW 846 6010B	8/9/2012	-	0.524	mg/kg	19

Cobalt	SW 846 6010B	8/9/2012	-	4.15	mg/kg	1600
Lead	SW 846 6010B	8/9/2012	-	4.93	mg/kg	400
Manganese	SW 846 6010B	8/9/2012	-	298	mg/kg	11000
Chromium	SW 846 6010B	8/9/2012	-	7.69	mg/Kg	-
Copper	SW 846 6010B	8/9/2012	-	5.71	mg/kg	3100
Silver	SW 846 6010B	8/9/2012	-	<0.55	mg/Kg	390
Thallium	SW 846 6010B	8/9/2012	-	<0.55	mg/kg	5
Antimony	SW 846 6010B	8/9/2012	-	<0.55	mg/kg	31
Barium	SW 846 6010B	8/9/2012	-	34.7	mg/kg	16000
Vanadium	SW 846 6010B	8/9/2012	-	12.6	mg/kg	78
Selenium	SW 846 6010B	8/9/2012	-	<0.69	mg/kg	390
Zinc	SW 846 6010B	8/9/2012	-	15.7	mg/kg	23000
Iron	SW 846 6010B	8/9/2012	-	10700	mg/kg	-
Aluminum	SW 846 6010B	8/9/2012	-	4160	mg/kg	78000
Calcium	SW 846 6010B	8/9/2012	-	1170	mg/kg	-
Magnesium	SW 846 6010B	8/9/2012	-	1440	mg/kg	-
Sodium	SW 846 6010B	8/9/2012	-	248	mg/kg	-
Potassium	SW 846 6010B	8/9/2012	-	540	mg/kg	-

12080180-004 8/5/2012, 12:09:00 PM Soil - SRS Limits

Rt. 3, bridge 4 - D1-5

Click here to request additional or contingent analyses for this Sample ID.

Test	Method	Date Posted	MDL #	Result	Units	Limit
Total EPH	NJDEP-EPH	8/9/2012	-	<22	mg/Kg	-
Percent Solids	Gravimetric	8/7/2012	-	89.1	%	-
C10-C12 Aromatics	NJDEP-EPH	8/9/2012	-	NA	mg/Kg	-
C12-C16 Aliphatics	NJDEP-EPH	8/9/2012	-	NA	mg/Kg	-
C12-C16 Aromatics	NJDEP-EPH	8/9/2012	-	NA	mg/Kg	-
C16-C21 Aliphatics	NJDEP-EPH	8/9/2012	-	NA	mg/Kg	-
C16-C21 Aromatics	NJDEP-EPH	8/9/2012	-	NA	mg/Kg	-
C21-C36 Aromatics	NJDEP-EPH	8/9/2012	-	NA	mg/Kg	-
C21-C40 Aliphatics	NJDEP-EPH	8/9/2012	-	NA	mg/Kg	-
C9-C12 Aliphatics	NJDEP-EPH	8/9/2012	-	NA	mg/Kg	-
Pesticides	SW 846 8081A	8/9/2012	-	Results Listed Below	-	-

Compound	Qualifier	Type	MDL	Dilution	Result	Units	Limit
alpha-BHC	U	A	0.298	1	ND	µg/kg	100
beta-BHC	U	A	0.29	1	ND	µg/kg	400
gamma-BHC (Lindane)	U	A	0.231	1	ND	µg/kg	400
delta-BHC	U	A	0.224	1	ND	µg/kg	-
Aldrin	U	A	0.248	1	ND	µg/kg	40
Heptachlor	U	A	0.343	1	ND	µg/kg	100
Heptachlor Epoxide	U	A	0.375	1	ND	µg/kg	70
Endosulfan I	U	A	0.416	1	ND	µg/kg	-
Endosulfan II	U	A	0.279	1	ND	µg/kg	-
4,4'-DDE	U	A	0.263	1	ND	µg/kg	2000
4,4'-DDD	U	A	0.167	1	ND	µg/kg	3000
4,4'-DDT	U	A	0.286	1	ND	µg/kg	2000
Dieldrin	U	A	0.301	1	ND	µg/kg	40
Endrin	U	A	0.289	1	ND	µg/kg	23000
Endrin Aldehyde	U	A	0.619	1	ND	µg/kg	-
Endrin Ketone	U	A	0.268	1	ND	µg/kg	-

Endosulfan Sulfate	U	A	0.265	1	ND	µg/kg	470000
Methoxychlor	U	A	0.336	1	ND	µg/kg	390000
Chlordane	U	A	0.574	1	ND	µg/kg	200
Toxaphene	U	A	4.06	1	ND	µg/kg	600

Semivolatile Organics SW 846 B270C 8/9/2012 - Results Listed Below -

Compound	Qualifier	Type	MDL	Dilution	Result	Units	Limit
Pyridine	U	A	215	1	ND	ug/kg	-
n-Nitroso-dimethylamine	U	A	337	1	ND	ug/kg	-
Benzaldehyde	U	A	111	1	ND	ug/kg	-
Aniline	U	A	16.5	1	ND	ug/kg	-
Phenol	U	A	16.5	1	ND	ug/kg	-
bis(2-Chloroethyl)ether	U	A	23.2	1	ND	ug/kg	-
2-Chlorophenol	U	A	15.7	1	ND	ug/kg	-
1,3-Dichlorobenzene	U	A	22.4	1	ND	ug/kg	-
1,4-Dichlorobenzene	U	A	28.4	1	ND	ug/kg	-
Benzyl Alcohol	U	A	519	1	ND	ug/kg	-
1,2-Dichlorobenzene	U	A	17.2	1	ND	ug/kg	-
2-Methylphenol	U	A	17.2	1	ND	ug/kg	-
bis(2-Chloroisopropyl)ether	U	A	18.7	1	ND	ug/kg	-
Acetophenone	U	A	98.8	1	ND	ug/kg	-
3+4-Methylphenol	U	A	28.4	1	ND	ug/kg	-
n-Nitroso-di-n-propylamine	U	A	32.9	1	ND	ug/kg	-
Hexachloroethane	U	A	21.0	1	ND	ug/kg	-
Nitrobenzene	U	A	15.0	1	ND	ug/kg	-
Isophorone	U	A	15.7	1	ND	ug/kg	-
2-Nitrophenol	U	A	159	1	ND	ug/kg	-
2,4-Dimethylphenol	U	A	21.0	1	ND	ug/kg	-
bis(2-Chloroethoxy)methane	U	A	25.4	1	ND	ug/kg	-
2,4-Dichlorophenol	U	A	46.4	1	ND	ug/kg	-
Benzoic Acid	U	A	474	1	ND	ug/kg	-
1,2,4-Trichlorobenzene	U	A	26.2	1	ND	ug/kg	-
Naphthalene	U	A	16.5	1	ND	ug/kg	-
2,6-Dichlorophenol	U	A	19.5	1	ND	ug/kg	-
4-Chloroaniline	U	A	22.4	1	ND	ug/kg	-
Hexachlorobutadiene	U	A	21.7	1	ND	ug/kg	-
Caprolactam	U	A	68.1	1	ND	ug/kg	-
4-Chloro-3-methylphenol	U	A	26.2	1	ND	ug/kg	-
2-Methylnaphthalene	U	A	19.5	1	ND	ug/kg	-
Hexachlorocyclopentadiene	U	A	307	1	ND	ug/kg	-
1,2,4,5-Tetrachlorobenzene	U	A	19.5	1	ND	ug/kg	-
2,4,6-Trichlorophenol	U	A	19.5	1	ND	ug/kg	-
2,4,5-Trichlorophenol	U	A	38.2	1	ND	ug/kg	-
Biphenyl	U	A	73.3	1	ND	ug/kg	-
2-Chloronaphthalene	U	A	15.0	1	ND	ug/kg	-
2-Nitroaniline	U	A	8.23	1	ND	ug/kg	-
Dimethylphthalate		A	21.7	1	249	ug/kg	-
Acenaphthylene	U	A	12.0	1	ND	ug/kg	-
2,6-Dinitrotoluene	U	A	31.4	1	ND	ug/kg	-
3-Nitroaniline	U	A	365	1	ND	ug/kg	-
Acenaphthene	U	A	15.0	1	ND	ug/kg	-
2,4-Dinitrophenol	U	A	29.2	1	ND	ug/kg	-
Dibenzofuran	U	A	16.5	1	ND	ug/kg	-

APL Result Retrieval System - Detailed Report

4-Nitrophenol	U	A	98.0	1	ND	ug/kg	-
2,4-Dinitrotoluene	U	A	29.2	1	ND	ug/kg	-
2,3,4,6-Tetrachlorophenol	U	A	487	1	ND	ug/kg	-
Fluorene	U	A	11.2	1	ND	ug/kg	-
Diethylphthalate	U	A	808	1	ND	ug/kg	-
4-Chlorophenyl phenyl ether	U	A	20.2	1	ND	ug/kg	-
4-Nitroaniline	U	A	205	1	ND	ug/kg	-
4,6-Dinitro-2-methylphenol	U	A	212	1	ND	ug/kg	-
n-Nitrosodiphenylamine	U	A	16.5	1	ND	ug/kg	-
1,2-Diphenylhydrazine	U	A	12.7	1	ND	ug/kg	-
4-Bromophenyl-phenyl ether	U	A	23.9	1	ND	ug/kg	-
Hexachlorobenzene	U	A	33.7	1	ND	ug/kg	-
Atrazine	U	A	61.4	1	ND	ug/kg	-
Pentachlorophenol	U	A	159	1	ND	ug/kg	-
Phenanthrene	U	A	5.99	1	ND	ug/kg	-
Anthracene	U	A	10.5	1	ND	ug/kg	-
Carbazole	U	A	23.2	1	ND	ug/kg	-
Di-n-butylphthalate	U	A	35.9	1	ND	ug/kg	-
Fluoranthene	U	A	18.7	1	ND	ug/kg	-
Benzidine	U	A	351	1	ND	ug/kg	-
Pyrene	U	A	10.5	1	ND	ug/kg	-
Butylbenzylphthalate	U	A	14.2	1	ND	ug/kg	-
Benzo(a)anthracene	U	A	12.7	1	ND	ug/kg	-
3,3'-Dichlorobenzidine	U	A	196	1	ND	ug/kg	-
Chrysene	U	A	15.0	1	ND	ug/kg	-
bis(2-Ethylhexyl)phthalate	U	A	256	1	ND	ug/kg	-
Di-n-octylphthalate	U	A	23.2	1	ND	ug/kg	-
Benzo(b)fluoranthene	U	A	25.4	1	ND	ug/kg	-
Benzo(k)fluoranthene	U	A	20.2	1	ND	ug/kg	-
Benzo(a)pyrene	U	A	14.2	1	ND	ug/kg	-
Indeno(1,2,3-cd)pyrene	U	A	9.73	1	ND	ug/kg	-
Dibenzo(a,h)anthracene	U	A	12.0	1	ND	ug/kg	-
Benzo(g,h,i)perylene	U	A	19.5	1	ND	ug/kg	-
Phosphonic acid, dioctadecyl ester	JN	T	-	-	434	ug/kg	-
unknown	J	T	-	-	414	ug/kg	-
unknown	J	T	-	-	453	ug/kg	-
unknown	J	T	-	-	2751	ug/kg	-
TIC (Total)	-	T (Sum)	-	-	-	-	-

PCBs	SW 846 8082	8/9/2012	MDL	Dilution	Result	Units	Limit
Compound	Qualifier	Type	MDL	Dilution	Result	Units	Limit
Aroclor 1016	U	A	2.65	1	ND	µg/kg	200
Aroclor 1221	U	A	3.34	1	ND	µg/kg	200
Aroclor 1232	U	A	3.93	1	ND	µg/kg	200
Aroclor 1242	U	A	1.82	1	ND	µg/kg	200
Aroclor 1248	U	A	1.25	1	ND	µg/kg	200
Aroclor 1254	U	A	2.79	1	ND	µg/kg	200
Aroclor 1260	U	A	2.68	1	ND	µg/kg	200
Aroclor 1262	U	A	2.74	1	ND	µg/kg	200
Aroclor 1268	U	A	2.02	1	ND	µg/kg	200
Cyanide	SW 846 9010B	8/8/2012	-	-	<0.28	mg/Kg	1600
Mercury	SW 846 7471A	8/9/2012	-	-	<0.019	mg/kg	23
Beryllium	SW 846 6010B	8/9/2012	-	-	0.0503	mg/kg	16

APL Result Retrieval System - Detailed Report

Element	Sample ID	Date	Result	Units	Limit
Cadmium	SW 846 6010B	8/9/2012	<0.07	mg/kg	78
Nickel	SW 846 6010B	8/9/2012	10.8	mg/kg	1600
Arsenic	SW 846 6010B	8/9/2012	0.991	mg/kg	19
Cobalt	SW 846 6010B	8/9/2012	6.02	mg/kg	1600
Lead	SW 846 6010B	8/9/2012	6.45	mg/kg	400
Manganese	SW 846 6010B	8/9/2012	396	mg/Kg	11000
Chromium	SW 846 6010B	8/9/2012	11.8	mg/kg	-
Copper	SW 846 6010B	8/9/2012	7.56	mg/kg	3100
Silver	SW 846 6010B	8/9/2012	<0.71	mg/Kg	390
Thallium	SW 846 6010B	8/9/2012	<0.71	mg/kg	5
Antimony	SW 846 6010B	8/9/2012	<0.71	mg/kg	31
Barium	SW 846 6010B	8/9/2012	47.6	mg/kg	16000
Vanadium	SW 846 6010B	8/9/2012	20.3	mg/kg	78
Selenium	SW 846 6010B	8/9/2012	<0.89	mg/kg	390
Zinc	SW 846 6010B	8/9/2012	23.6	mg/kg	23000
Iron	SW 846 6010B	8/9/2012	15400	mg/kg	-
Aluminum	SW 846 6010B	8/9/2012	7820	mg/kg	78000
Calcium	SW 846 6010B	8/9/2012	945	mg/kg	-
Magnesium	SW 846 6010B	8/9/2012	1920	mg/kg	-
Sodium	SW 846 6010B	8/9/2012	582	mg/kg	-
Potassium	SW 846 6010B	8/9/2012	637	mg/kg	-

Rt. 3. Bridge 4 - A1 **12080180-005** 8/6/2012, 11:24:00 AM Soil - SRS Limits

Click here to request additional or contingent analyses for this Sample ID.

Test	Method	Date Posted	MDL #	Result	Units	Limit
Percent Solids	Gravimetric	8/7/2012	-	92.5	%	-
Volatle Organics	SW 846 8260B	8/9/2012	-	Results Listed Below	-	-

Compound	Qualifier	Type	MDL	Dilution	Result	Units	Limit
Dichlorodifluoromethane	U	A	1.20	1	ND	ug/kg	-
Chloromethane	U	A	0.703	1	ND	ug/kg	-
Vinyl Chloride	U	A	1.02	1	ND	ug/kg	-
Bromomethane	U	A	1.85	1	ND	ug/kg	-
Chloroethane	U	A	2.46	1	ND	ug/kg	-
Trichlorofluoromethane	U	A	1.26	1	ND	ug/kg	-
1,1,2-Trichloro-1,2,2 trfluoroethane	U	A	2.26	1	ND	ug/kg	-
Acetone	U	A	3.10	1	ND	ug/kg	-
1,1-Dichloroethene	U	A	1.46	1	ND	ug/kg	-
tert-Butyl Alcohol	U	A	10.5	1	ND	ug/kg	-
Methyl Acetate	U	A	1.03	1	ND	ug/kg	-
Methylene Chloride	U	A	0.886	1	ND	ug/kg	-
Carbon Disulfide	U	A	0.746	1	ND	ug/kg	-
Methyl tert-Butyl Ether	U	A	0.941	1	ND	ug/kg	-
trans-1,2-Dichloroethene	U	A	0.724	1	ND	ug/kg	-
1,1-Dichloroethane	U	A	0.908	1	ND	ug/kg	-
2-Butanone	U	A	2.22	1	ND	ug/kg	-
cis-1,2-Dichloroethene	U	A	0.562	1	ND	ug/kg	-
Chloroform	U	A	0.843	1	ND	ug/kg	-
Bromochloromethane	U	A	1.02	1	ND	ug/kg	-
Cyclohexane	U	A	1.09	1	ND	ug/kg	-
1,1,1-Trichloroethane	U	A	1.23	1	ND	ug/kg	-

Carbon Tetrachloride	U	A	0.941	1	ND	ug/kg	-
1,2-Dichloroethane	U	A	0.616	1	ND	ug/kg	-
Benzene	U	A	0.595	1	ND	ug/kg	-
Trichloroethene	U	A	0.886	1	ND	ug/kg	-
Methylcyclohexane	U	A	1.10	1	ND	ug/kg	-
1,2-Dichloropropane	U	A	0.854	1	ND	ug/kg	-
Bromodichloromethane	U	A	0.832	1	ND	ug/kg	-
4-Methyl-2-Pentanone	U	A	0.811	1	ND	ug/kg	-
cis-1,3-Dichloropropene	U	A	0.205	1	ND	ug/kg	-
Toluene	U	A	0.389	1	ND	ug/kg	-
trans-1,3-Dichloropropene	U	A	0.476	1	ND	ug/kg	-
1,1,2-Trichloroethane	U	A	0.735	1	ND	ug/kg	-
2-Hexanone	U	A	1.19	1	ND	ug/kg	-
Tetrachloroethene	U	A	0.724	1	ND	ug/kg	-
Dibromochloromethane	U	A	0.735	1	ND	ug/kg	-
1,2-Dibromoethane	U	A	0.411	1	ND	ug/kg	-
Chlorobenzene	U	A	0.465	1	ND	ug/kg	-
Ethylbenzene	U	A	0.432	1	ND	ug/kg	-
m+p-Xylenes	U	A	1.04	1	ND	ug/kg	-
o-Xylene	U	A	0.854	1	ND	ug/kg	-
Styrene	U	A	0.681	1	ND	ug/kg	-
Isopropylbenzene	U	A	0.562	1	ND	ug/kg	-
Bromoform	U	A	1.94	1	ND	ug/kg	-
1,1,2,2-Tetrachloroethane	U	A	1.54	1	ND	ug/kg	-
1,3-Dichlorobenzene	U	A	0.897	1	ND	ug/kg	-
1,4-Dichlorobenzene	U	A	0.919	1	ND	ug/kg	-
1,2-Dichlorobenzene	U	A	0.778	1	ND	ug/kg	-
1,2-Dibromo-3-chloropropane	U	A	4.88	1	ND	ug/kg	-
1,2,4-Trichlorobenzene	U	A	1.06	1	ND	ug/kg	-
1,2,3-Trichlorobenzene	U	A	1.95	1	ND	ug/kg	-
No TICs Detected		T			0	ug	-

No TICs Detected/Reported for this test.

Test	Method	Date Posted	MDL #	Result	Units	Limit	
Percent Solids	Gravimetric	8/7/2012	-	94.7	%	-	
Volatile Organics	SW 846 8260B	8/9/2012	-	Results Listed Below	-	-	
Compound	Qualifier	Type	MDL	Dilution	Result	Units	Limit
Dichlorodifluoromethane	U	A	1.17	1	ND	ug/kg	-
Chloromethane	U	A	0.686	1	ND	ug/kg	-
Vinyl Chloride	U	A	0.993	1	ND	ug/kg	-
Bromomethane	U	A	1.81	1	ND	ug/kg	-
Chloroethane	U	A	2.41	1	ND	ug/kg	-
Trichlorofluoromethane	U	A	1.24	1	ND	ug/kg	-
1,1,2-Trichloro-1,2,2 trifluoroethane	U	A	2.21	1	ND	ug/kg	-
Acetone	U	A	3.03	1	ND	ug/kg	-
1,1-Dichloroethene	U	A	1.43	1	ND	ug/kg	-
tert-Butyl Alcohol	U	A	10.3	1	ND	ug/kg	-
Methyl Acetate	U	A	1.00	1	ND	ug/kg	-
Methylene Chloride	U	A	0.866	1	ND	ug/kg	-

Carbon Disulfide	U	A	0.729	1	ND	ug/kg	-
Methyl tert-Butyl Ether	U	A	0.919	1	ND	ug/kg	-
trans-1,2-Dichloroethene	U	A	0.708	1	ND	ug/kg	-
1,1-Dichloroethane	U	A	0.887	1	ND	ug/kg	-
2-Butanone	U	A	2.16	1	ND	ug/kg	-
cis-1,2-Dichloroethene	U	A	0.549	1	ND	ug/kg	-
Chloroform	U	A	0.824	1	ND	ug/kg	-
Bromochloromethane	U	A	0.993	1	ND	ug/kg	-
Cyclohexane	U	A	1.07	1	ND	ug/kg	-
1,1,1-Trichloroethane	U	A	1.20	1	ND	ug/kg	-
Carbon Tetrachloride	U	A	0.919	1	ND	ug/kg	-
1,2-Dichloroethane	U	A	0.602	1	ND	ug/kg	-
Benzene	U	A	0.581	1	ND	ug/kg	-
Trichloroethene	U	A	0.866	1	ND	ug/kg	-
Methylcyclohexane	U	A	1.08	1	ND	ug/kg	-
1,2-Dichloropropane	U	A	0.834	1	ND	ug/kg	-
Bromodichloromethane	U	A	0.813	1	ND	ug/kg	-
4-Methyl-2-Pentanone	U	A	0.792	1	ND	ug/kg	-
cis-1,3-Dichloropropene	U	A	0.201	1	ND	ug/kg	-
Toluene	U	A	0.380	1	ND	ug/kg	-
trans-1,3-Dichloropropene	U	A	0.465	1	ND	ug/kg	-
1,1,2-Trichloroethane	U	A	0.718	1	ND	ug/kg	-
2-Hexanone	U	A	1.16	1	ND	ug/kg	-
Tetrachloroethene	U	A	0.708	1	ND	ug/kg	-
Dibromochloromethane	U	A	0.718	1	ND	ug/kg	-
1,2-Dibromoethane	U	A	0.401	1	ND	ug/kg	-
Chlorobenzene	U	A	0.454	1	ND	ug/kg	-
Ethylbenzene	U	A	0.422	1	ND	ug/kg	-
m+p-Xylenes	U	A	1.01	1	ND	ug/kg	-
o-Xylene	U	A	0.834	1	ND	ug/kg	-
Styrene	U	A	0.665	1	ND	ug/kg	-
Isopropylbenzene	U	A	0.549	1	ND	ug/kg	-
Bromoform	U	A	1.89	1	ND	ug/kg	-
1,1,2,2-Tetrachloroethane	U	A	1.50	1	ND	ug/kg	-
1,3-Dichlorobenzene	U	A	0.876	1	ND	ug/kg	-
1,4-Dichlorobenzene	U	A	0.898	1	ND	ug/kg	-
1,2-Dichlorobenzene	U	A	0.760	1	ND	ug/kg	-
1,2-Dibromo-3-chloropropane	U	A	4.76	1	ND	ug/kg	-
1,2,4-Trichlorobenzene	U	A	1.03	1	ND	ug/kg	-
1,2,3-Trichlorobenzene	U	A	1.90	1	ND	ug/kg	-
No TICs Detected		T			0	ug	-

No TICs Detected/Reported for this test.

Test	Method	Date Posted	MDL #	Result	Units	Limit	
Percent Solids	Gravimetric	8/7/2012	-	93.2	%	-	
Volatle Organics	SW 846 8260B	8/9/2012	-	Results Listed Below	-	-	
Compound	Qualifier	Type	MDL	Dilution	Result	Units	Limit
Dichlorodifluoromethane	U	A	1.19	1	ND	ug/kg	-
Chloromethane	U	A	0.697	1	ND	ug/kg	-

Vinyl Chloride	U	A	1.01	1	ND	ug/kg	-
Bromomethane	U	A	1.83	1	ND	ug/kg	-
Chloroethane	U	A	2.45	1	ND	ug/kg	-
Trichlorofluoromethane	U	A	1.26	1	ND	ug/kg	-
1,1,2-Trichloro-1,2,2 trifluoroethane	U	A	2.24	1	ND	ug/kg	-
Acetone	U	A	3.08	1	ND	ug/kg	-
1,1-Dichloroethene	U	A	1.45	1	ND	ug/kg	-
tert-Butyl Alcohol	U	A	10.5	1	ND	ug/kg	-
Methyl Acetate	U	A	1.02	1	ND	ug/kg	-
Methylene Chloride	U	A	0.880	1	ND	ug/kg	-
Carbon Disulfide	U	A	0.740	1	ND	ug/kg	-
Methyl tert-Butyl Ether	U	A	0.933	1	ND	ug/kg	-
trans-1,2-Dichloroethene	U	A	0.719	1	ND	ug/kg	-
1,1-Dichloroethane	U	A	0.901	1	ND	ug/kg	-
2-Butanone	U	A	2.20	1	ND	ug/kg	-
cis-1,2-Dichloroethene	U	A	0.558	1	ND	ug/kg	-
Chloroform	U	A	0.837	1	ND	ug/kg	-
Bromochloromethane	U	A	1.01	1	ND	ug/kg	-
Cyclohexane	U	A	1.08	1	ND	ug/kg	-
1,1,1-Trichloroethane	U	A	1.22	1	ND	ug/kg	-
Carbon Tetrachloride	U	A	0.933	1	ND	ug/kg	-
1,2-Dichloroethane	U	A	0.612	1	ND	ug/kg	-
Benzene	U	A	0.590	1	ND	ug/kg	-
Trichloroethene	U	A	0.880	1	ND	ug/kg	-
Methylcyclohexane	U	A	1.09	1	ND	ug/kg	-
1,2-Dichloropropane	U	A	0.848	1	ND	ug/kg	-
Bromodichloromethane	U	A	0.826	1	ND	ug/kg	-
4-Methyl-2-Pentanone	U	A	0.805	1	ND	ug/kg	-
cis-1,3-Dichloropropene	U	A	0.204	1	ND	ug/kg	-
Toluene	U	A	0.386	1	ND	ug/kg	-
trans-1,3-Dichloropropene	U	A	0.472	1	ND	ug/kg	-
1,1,2-Trichloroethane	U	A	0.730	1	ND	ug/kg	-
2-Hexanone	U	A	1.18	1	ND	ug/kg	-
Tetrachloroethene	U	A	0.719	1	ND	ug/kg	-
Dibromochloromethane	U	A	0.730	1	ND	ug/kg	-
1,2-Dibromoethane	U	A	0.408	1	ND	ug/kg	-
Chlorobenzene	U	A	0.461	1	ND	ug/kg	-
Ethylbenzene	U	A	0.429	1	ND	ug/kg	-
m+p-Xylenes	U	A	1.03	1	ND	ug/kg	-
o-Xylene	U	A	0.848	1	ND	ug/kg	-
Styrene	U	A	0.676	1	ND	ug/kg	-
Isopropylbenzene	U	A	0.558	1	ND	ug/kg	-
Bromofom	U	A	1.92	1	ND	ug/kg	-
1,1,2,2-Tetrachloroethane	U	A	1.52	1	ND	ug/kg	-
1,3-Dichlorobenzene	U	A	0.891	1	ND	ug/kg	-
1,4-Dichlorobenzene	U	A	0.912	1	ND	ug/kg	-
1,2-Dichlorobenzene	U	A	0.773	1	ND	ug/kg	-
1,2-Dibromo-3-chloropropane	U	A	4.84	1	ND	ug/kg	-
1,2,4-Trichlorobenzene	U	A	1.05	1	ND	ug/kg	-
1,2,3-Trichlorobenzene	U	A	1.93	1	ND	ug/kg	-
No TICs Detected		T			0	ug	-

No TICs Detected/Reported for this test.


Rt. 3. Bridge 4 - D2		12080180-008		8/6/2012, 12:09:00 PM		Soll - SRS Limits	
Click here to request additional or contingent analyses for this Sample ID.							
Test	Method	Date Posted	MDL #	Result	Units	Limit	
Percent Solids	Gravimetric	8/7/2012	-	89	%	-	
Volatile Organics	SW 846 8260B	8/9/2012	-	Results Listed Below		-	
Compound	Qualifier	Type	MDL	Dilution	Result	Units	Limit
Dichlorodifluoromethane	U	A	1.25	1	ND	ug/kg	-
Chloromethane	U	A	0.730	1	ND	ug/kg	-
Vinyl Chloride	U	A	1.06	1	ND	ug/kg	-
Bromomethane	U	A	1.92	1	ND	ug/kg	-
Chloroethane	U	A	2.56	1	ND	ug/kg	-
Trichlorofluoromethane	U	A	1.31	1	ND	ug/kg	-
1,1,2-Trichloro-1,2,2 trifluoroethane	U	A	2.35	1	ND	ug/kg	-
Acetone	U	A	3.22	1	ND	ug/kg	-
1,1-Dichloroethene	U	A	1.52	1	ND	ug/kg	-
tert-Butyl Alcohol	U	A	11.0	1	ND	ug/kg	-
Methyl Acetate	U	A	1.07	1	ND	ug/kg	-
Methylene Chloride	U	A	0.921	1	ND	ug/kg	-
Carbon Disulfide	U	A	0.775	1	ND	ug/kg	-
Methyl tert-Butyl Ether	U	A	0.978	1	ND	ug/kg	-
trans-1,2-Dichloroethene	U	A	0.753	1	ND	ug/kg	-
1,1-Dichloroethane	U	A	0.944	1	ND	ug/kg	-
2-Butanone	U	A	2.30	1	ND	ug/kg	-
cis-1,2-Dichloroethene	U	A	0.584	1	ND	ug/kg	-
Chloroform	U	A	0.876	1	ND	ug/kg	-
Bromochloromethane	U	A	1.06	1	ND	ug/kg	-
Cyclohexane	U	A	1.13	1	ND	ug/kg	-
1,1,1-Trichloroethane	U	A	1.28	1	ND	ug/kg	-
Carbon Tetrachloride	U	A	0.978	1	ND	ug/kg	-
1,2-Dichloroethane	U	A	0.640	1	ND	ug/kg	-
Benzene	U	A	0.618	1	ND	ug/kg	-
Trichloroethene	U	A	0.921	1	ND	ug/kg	-
Methylcyclohexane	U	A	1.15	1	ND	ug/kg	-
1,2-Dichloropropane	U	A	0.888	1	ND	ug/kg	-
Bromodichloromethane	U	A	0.865	1	ND	ug/kg	-
4-Methyl-2-Pentanone	U	A	0.843	1	ND	ug/kg	-
cis-1,3-Dichloropropene	U	A	0.213	1	ND	ug/kg	-
Toluene	U	A	0.404	1	ND	ug/kg	-
trans-1,3-Dichloropropene	U	A	0.494	1	ND	ug/kg	-
1,1,2-Trichloroethane	U	A	0.764	1	ND	ug/kg	-
2-Hexanone	U	A	1.24	1	ND	ug/kg	-
Tetrachloroethene	U	A	0.753	1	ND	ug/kg	-
Dibromochloromethane	U	A	0.764	1	ND	ug/kg	-
1,2-Dibromoethane	U	A	0.427	1	ND	ug/kg	-
Chlorobenzene	U	A	0.483	1	ND	ug/kg	-
Ethylbenzene	U	A	0.449	1	ND	ug/kg	-
m+p-Xylenes	U	A	1.08	1	ND	ug/kg	-
o-Xylene	U	A	0.888	1	ND	ug/kg	-
Styrene	U	A	0.708	1	ND	ug/kg	-
Isopropylbenzene	U	A	0.584	1	ND	ug/kg	-
Bromoform	U	A	2.01	1	ND	ug/kg	-
1,1,2,2-Tetrachloroethane	U	A	1.60	1	ND	ug/kg	-
1,3-Dichlorobenzene	U	A	0.933	1	ND	ug/kg	-

1,4-Dichlorobenzene	U	A	0.955	1	ND	ug/kg	-
1,2-Dichlorobenzene	U	A	0.809	1	ND	ug/kg	-
1,2-Dibromo-3-chloropropane	U	A	5.07	1	ND	ug/kg	-
1,2,4-Trichlorobenzene	U	A	1.10	1	ND	ug/kg	-
1,2,3-Trichlorobenzene	U	A	2.02	1	ND	ug/kg	-
No TICs Detected		T			0	ug	-
No TICs Detected/Reported for this test.							

Report Key:			Description
Result	Units	Limit	An asterisk and red highlight indicate that the concentration of the analyte exceeded its limit or optimum range. Click the Limit column header for that sample's limits, or visit the Documents page for a complete listing of limits for all matrices. For Soil and Wastewater the lowest limit is used. For Concrete the Soil Residential Direct Contact Soil Cleanup Criterion (RDCSCC) is used. For Groundwater the higher of the PQL and the Groundwater Quality Criterion is used.
x	mg/l	y *	
Qualifiers	‡		Some soil MDL's are not available on the RRS Website. See deliverable report for this information.
	U-		Indicates the compound was analyzed for but not detected.
	J-		Indicates an estimated value. All tentatively identified compounds (TICs) and results below the MDL receive this qualifier.
	N-		Indicates presumptive evidence of a compound. All TICs receive this qualifier.
	B-		Used if the analyte is found in the method blank as well as the sample.
	E-		Used for identification of compounds with concentrations exceeding the GC/MS calibration range.
	D-		Indicates results from a diluted sample.
	A-		Indicates an analyte, a target compound included in the calibration.
	T-		Indicates a tentatively identified compound (TIC). A TIC is a non-targeted compound, not included in the calibration, identified by a mass spectral library search.
Results	Dilution Needed-		Indicates that the compound had an E qualifier and needed a diluted re-analysis. If completed and made available, results for compounds with this notification can be found at the bottom of the test's compound list.
	ND-		Indicates the compound was analyzed for but not detected.
Other	PQL-		Practical Quantitation Limit
	MDL-		Method Detection Limit
Terms & Conditions	APL 8/2003		
The data on this website is preliminary. It is made available at the earliest possible time in order to better serve our clients. Final deliverable results will be provided by mail as usual.			

Questions, Comments, Feedback?

APL Result Retrieval System ©2002-2012 Aqua Pro-Tech Laboratories

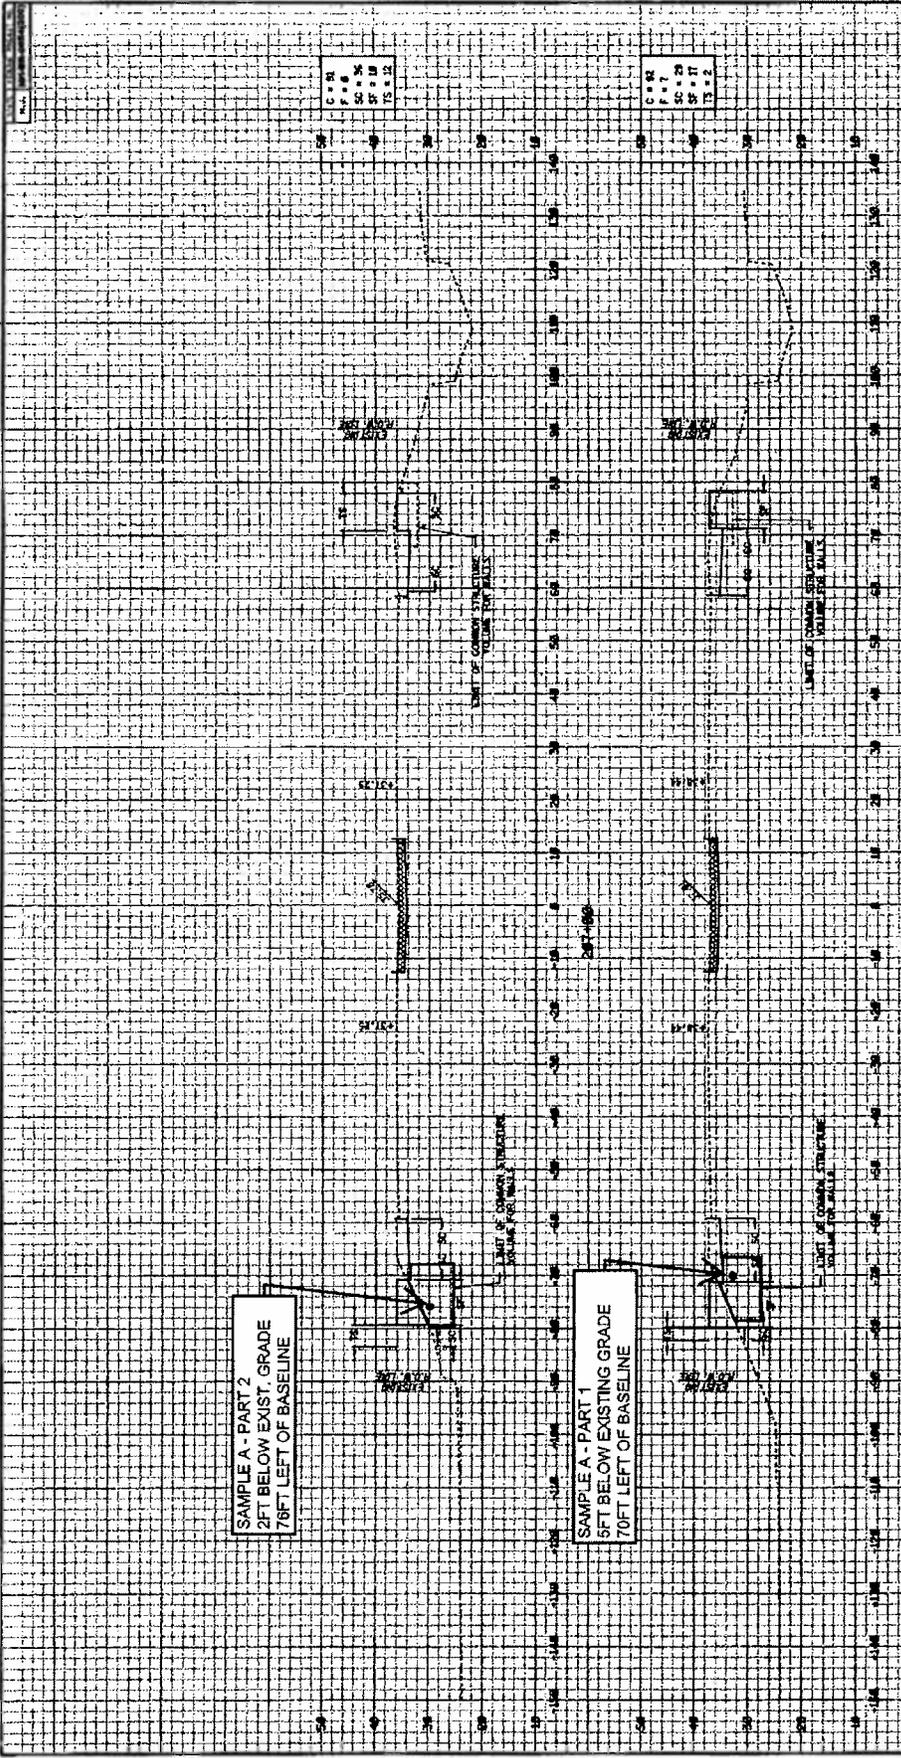

SAMPLE A - PART 2
2FT BELOW EXIST. GRADE
76FT LEFT OF BASELINE

SAMPLE A - PART 1
5FT BELOW EXISTING GRADE
70FT LEFT OF BASELINE

WALL 11 CROSS SECTIONS
SAMPLING PLAN # 6

CSJV JOB # 10-1796
7-10-12

CROSS SECTIONS
ROUTE 3 AT THE PASSAIC RIVER CROSSING
CONTRACT NO. 06-4378173
STATE OF NEW JERSEY
DEPARTMENT OF TRANSPORTATION
OFFICE OF THE CHIEF ENGINEER
1-20-12
SHEET 1 OF 3

SAMPLING NOTES

EXCESS SOIL SAMPLING PLAN #7
ABOUT 3,896 CY OR 5,844 TONS

1. FOUR 5-PART COMPOSITE SAMPLES WILL BE TAKEN FROM THIS STOCKPILE. EQUATING TO APPROXIMATELY ONE 5-PART COMPOSITE PER 974 CY.

2. DEPTH OF SAMPLES AS FOLLOWS
 AREA "A"
 SAMPLE 1: 5FT DEPTH
 SAMPLE 2: 7FT DEPTH
 SAMPLE 3: 3.5FT DEPTH
 SAMPLE 4: 9FT DEPTH
 SAMPLE 5: 2FT DEPTH

AREA "B"
 SAMPLE 1: 11FT DEPTH
 SAMPLE 2: 5.5FT DEPTH
 SAMPLE 3: 2FT DEPTH
 SAMPLE 4: 9FT DEPTH
 SAMPLE 5: 4FT DEPTH


AREA "C"
 SAMPLE 1: 10FT DEPTH
 SAMPLE 2: 3.5FT DEPTH
 SAMPLE 3: 6FT DEPTH
 SAMPLE 4: 2FT DEPTH
 SAMPLE 5: 5FT DEPTH

AREA "D"
 SAMPLE 1: 6.5FT DEPTH
 SAMPLE 2: 4FT DEPTH
 SAMPLE 3: 10FT DEPTH
 SAMPLE 4: 5FT DEPTH
 SAMPLE 5: 2.5FT DEPTH

3. SAMPLING TO BE PERFORMED BY AQUA-PRO TECH LABORATORIES FIELD TECH.

4. SAMPLING TECHNICIAN SHALL USE A STAINLESS STEEL SAMPLING SPATULA THAT WILL BE DECONTAMINATED BEFORE SAMPLING AND IN BETWEEN SAMPLING AT EACH COMPOSITE AREA OR USE DURABLE TEFLON SPATULAS.


5. MATERIAL WILL BE EXCAVATED VIA AN EXCAVATOR - PC400 OR SIMILAR. SAMPLING TECHNICIAN WILL THEN TAKE A SAMPLE FROM THE MATERIAL WITHIN THE EXCAVATOR'S BUCKET IN ACCORDANCE WITH NOTE #4.

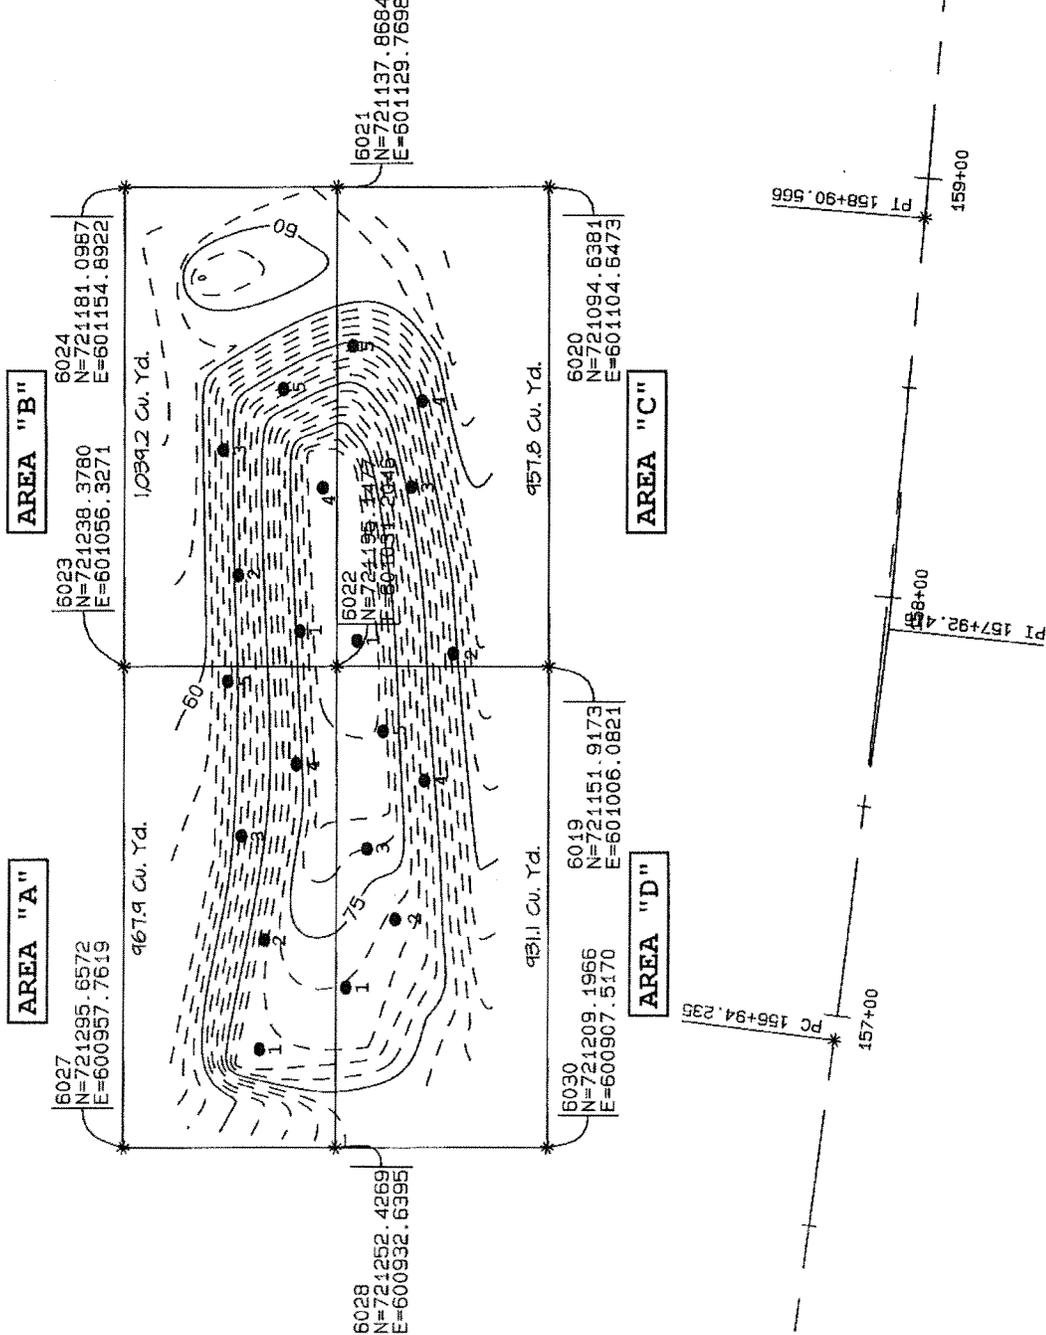

DATE (P&S) 08/28/2012	SCALE 1"=20'-0"
PROJECT NO. 00-4870173	DATE (REV) 08/28/2012
STRUCTURE NO.	RETAINING WALL NO. 12
STRUCTURE NAME	


SAMPLING NOTES:

- FOUR 5-PART COMPOSITE SAMPLES WILL BE TAKEN FROM WALL NO. 12 AT EACH OF THE 12 WALL PANELS. EQUIVANT TO APPROXIMATELY ONE 5-PART COMPOSITE PER 1,000 CY.
- SAMPLING TO BE PERFORMED BY AQUA-PRO TECH LABORATORIES FIELD TECH.
- SAMPLING TECHNICIAN SHALL USE A STAINLESS STEEL SAMPLING SPATULA THAT WILL BE DECONTAMINATED BEFORE SAMPLING AND IN BETWEEN SAMPLING AT EACH COMPOSITE AREA OR USE DURABLE TEFLON SPATULAS.
- MATERIAL WILL BE EXCAVATED VIA AN EXCAVATOR - PC400 OR SIMILAR. SAMPLING TECHNICIAN WILL THEN TAKE A SAMPLE FROM THE MATERIAL WITHIN THE EXCAVATOR'S BUCKET IN ACCORDANCE WITH NOTE #3.
- SEE ATTACHED CROSS-SECTIONS FOR DETAILED LOCATIONS OF EACH SAMPLE.

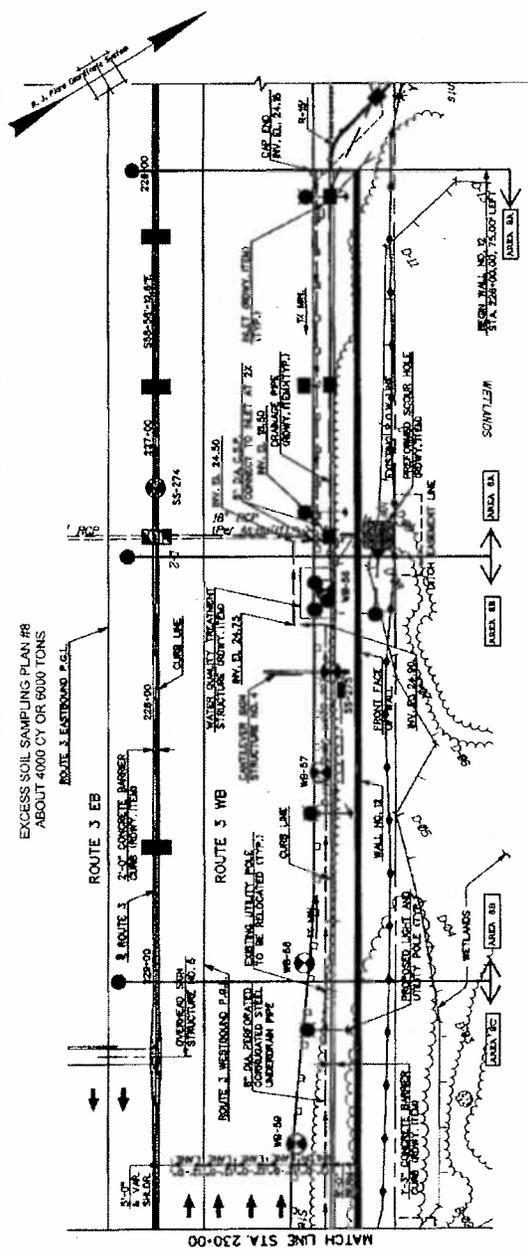

PLAN
SCALE 1" = 20'-0"

TOTAL LENGTH OF WALL = 705'-3" (ALONG FRONT FACE OF WALL)

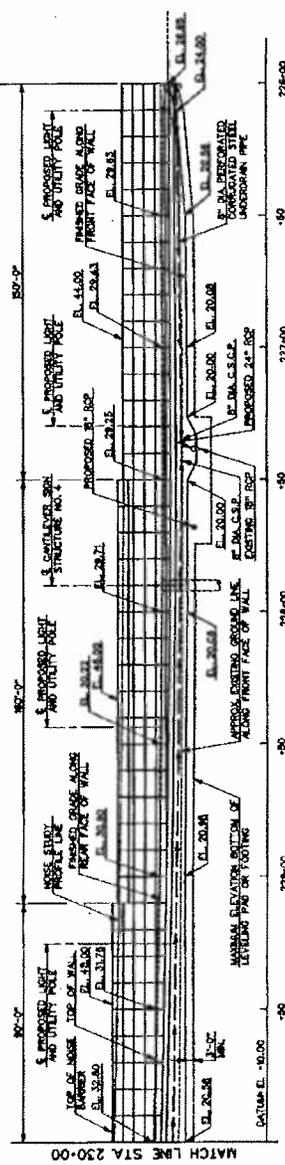

ELEVATION
SCALE 1" = 20'-0"

NEW BERRY & ASSOCIATES ENGINEERING

GENERAL PLAN AND ELEVATION I
ROUTE 3 AT THE PASSAC RIVER CROSSING
CONTRACT NO. 00-4870173
CLIFTON CITY
RUTHERFORD BOROUGH
PASSAIC COUNTY
BERGEN COUNTY

DATE: 08/28/12
BY: [Signature]
CHECKED BY: [Signature]
SCALE: AS SHOWN



PROJECT NO. 00-4870173
SHEET NO. 12 OF 12

DATE	BY	CHECKED BY
08/28/12	[Signature]	[Signature]
08/28/12	[Signature]	[Signature]
08/28/12	[Signature]	[Signature]


DATE: FEBRUARY 1982	NO. 12	DATE: 1982
STRUCTURE NO.	RETAINING WALL NO. 12	

SAMPLING NOTES:

1. FOUR 5-PART COMPOSITE SAMPLES WILL BE TAKEN FROM WALL NO. 12 COMMON STRUCTURE VOLUME, EQUATING TO APPROXIMATELY ONE 5-PART COMPOSITE PER 1,000 CY.
2. SAMPLING TO BE PERFORMED BY AQUA-PRO TECH LABORATORIES FIELD TECH.
3. SAMPLING TECHNICIAN SHALL USE 4 STAINLESS STEEL SAMPLING INSTRUMENTS TO BE DECONTAMINATED BEFORE SAMPLING AND IMMEDIATE SAMPLING AT EACH COMPOSITE AREA OR USE DURABLE TETRAFLUOROPOLYETHYLENE SPATULAS.
4. MATERIAL WILL BE EXCAVATED VIA AN EXCAVATOR - PC400 OR SIMILAR. SAMPLING TECHNICIAN WILL THEN TAKE A SAMPLE FROM THE MATERIAL WITHIN THE EXCAVATOR'S BUCKET IN ACCORDANCE WITH NOTE #3.
5. SEE ATTACHED CROSS-SECTIONS FOR DETAILED LOCATIONS OF EACH SAMPLE.

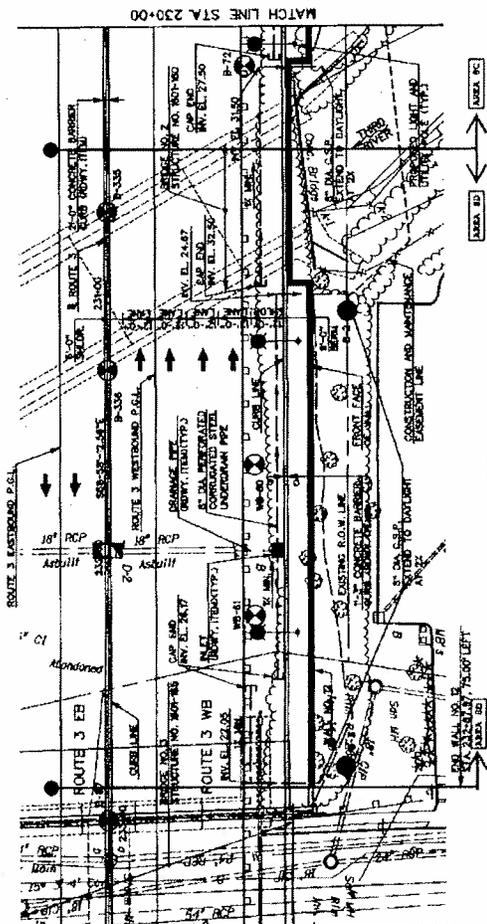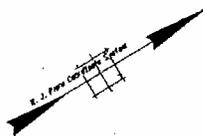


PLAN
SCALE 1"=20'-0"

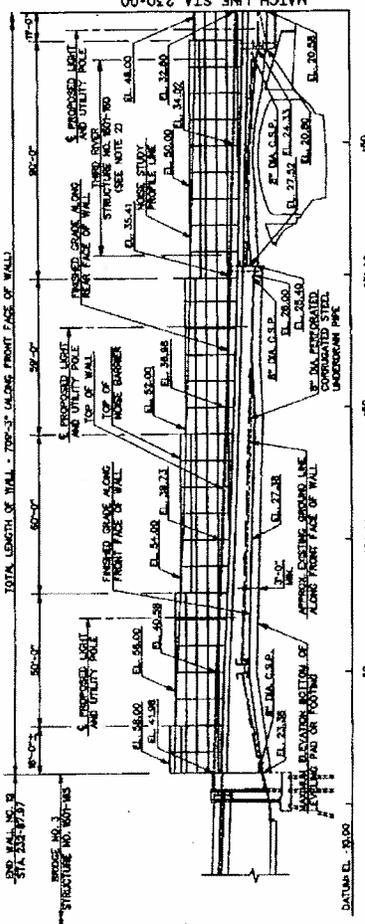


ELEVATION
SCALE 1"=20'-0"

WALL NO. 12
NEW
GENERAL PLAN AND ELEVATION II
ROUTE 3 AT THE PASSAIC RIVER CROSSING
CLIFTON CITY BOROUGH
BERGEN COUNTY
CONTRACT NO. 00497017
DATE: 1-8-79
BY: [Signature]
CHECKED BY: [Signature]
FOR: [Signature]

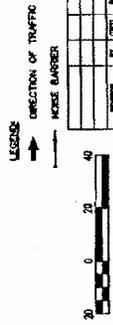

DATE: 1-8-79	NO. 12	DATE: 1982
STRUCTURE NO.	RETAINING WALL NO. 12	

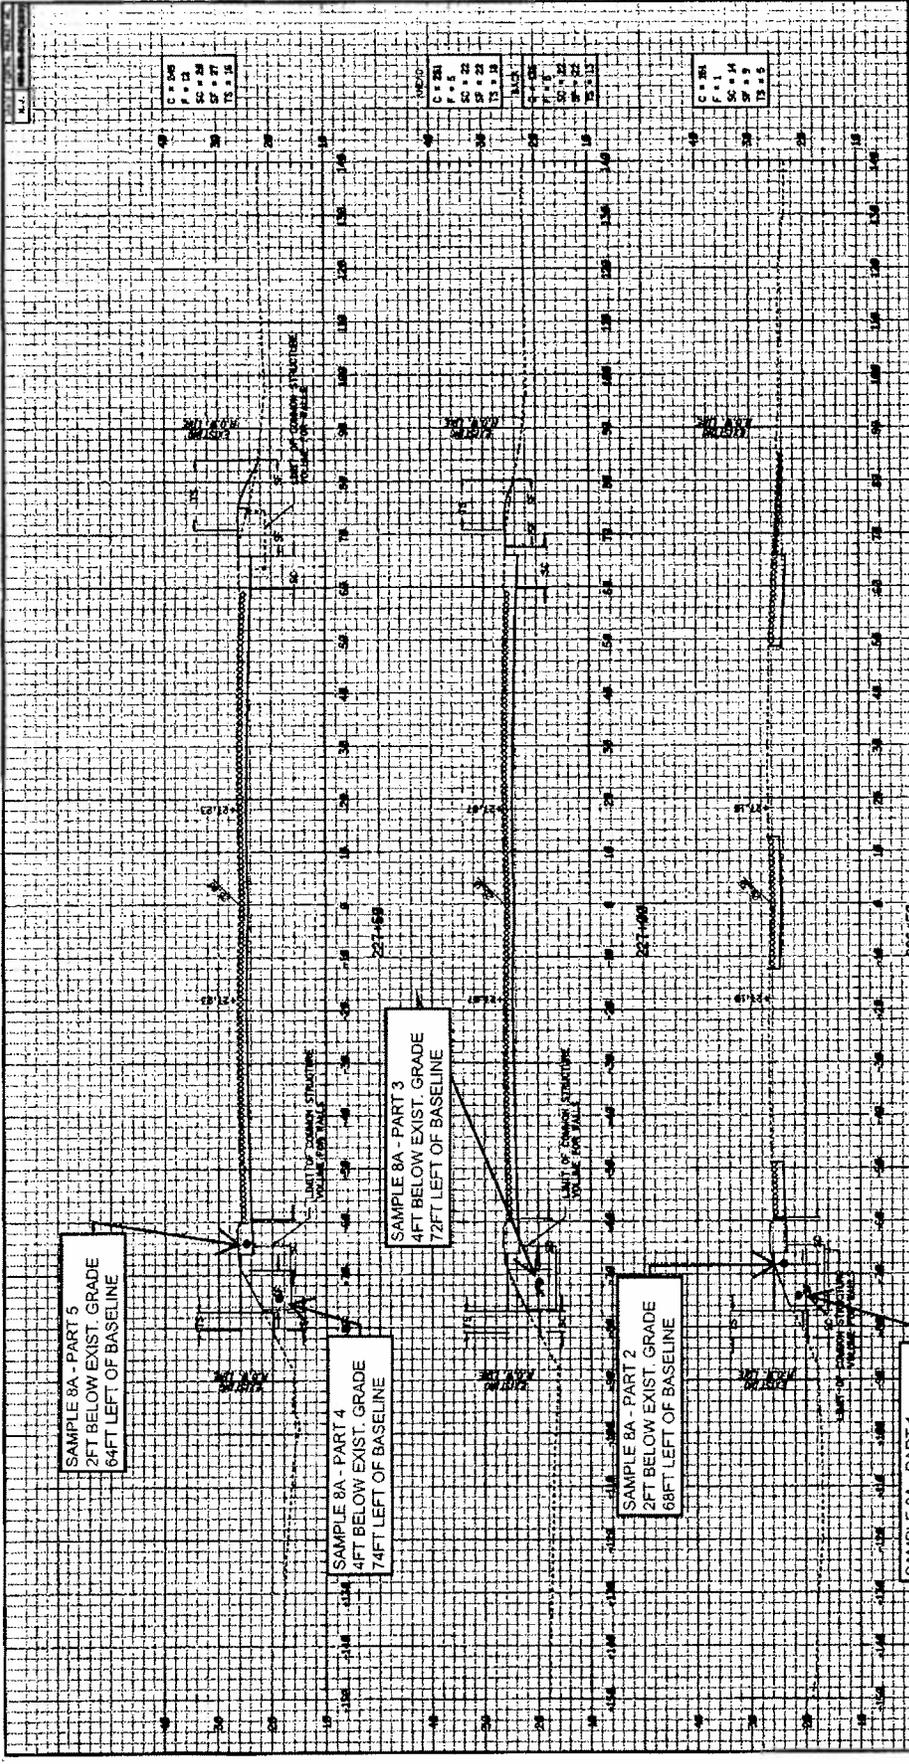

SAMPLE 8A - PART 5
2FT BELOW EXIST. GRADE
84FT LEFT OF BASELINE

SAMPLE 8A - PART 4
4FT BELOW EXIST. GRADE
74FT LEFT OF BASELINE

SAMPLE 8A - PART 3
4FT BELOW EXIST. GRADE
72FT LEFT OF BASELINE

SAMPLE 8A - PART 2
2FT BELOW EXIST. GRADE
68FT LEFT OF BASELINE


SAMPLE 8A - PART 1
2FT BELOW EXIST. GRADE
74FT LEFT OF BASELINE

ROUTE 3 B.L. STA. 226+00 TO STA. 227+50 CUTS
NEW JERSEY DEPARTMENT OF TRANSPORTATION


CROSS SECTIONS
ROUTE 3 AT THE PASSAIC RIVER CROSSING
CONTRACT NO. 88-4P18173

DATE: 12/1/76
BY: [Signature]
CHECKED BY: [Signature]
SCALE: 1" = 10'-0"




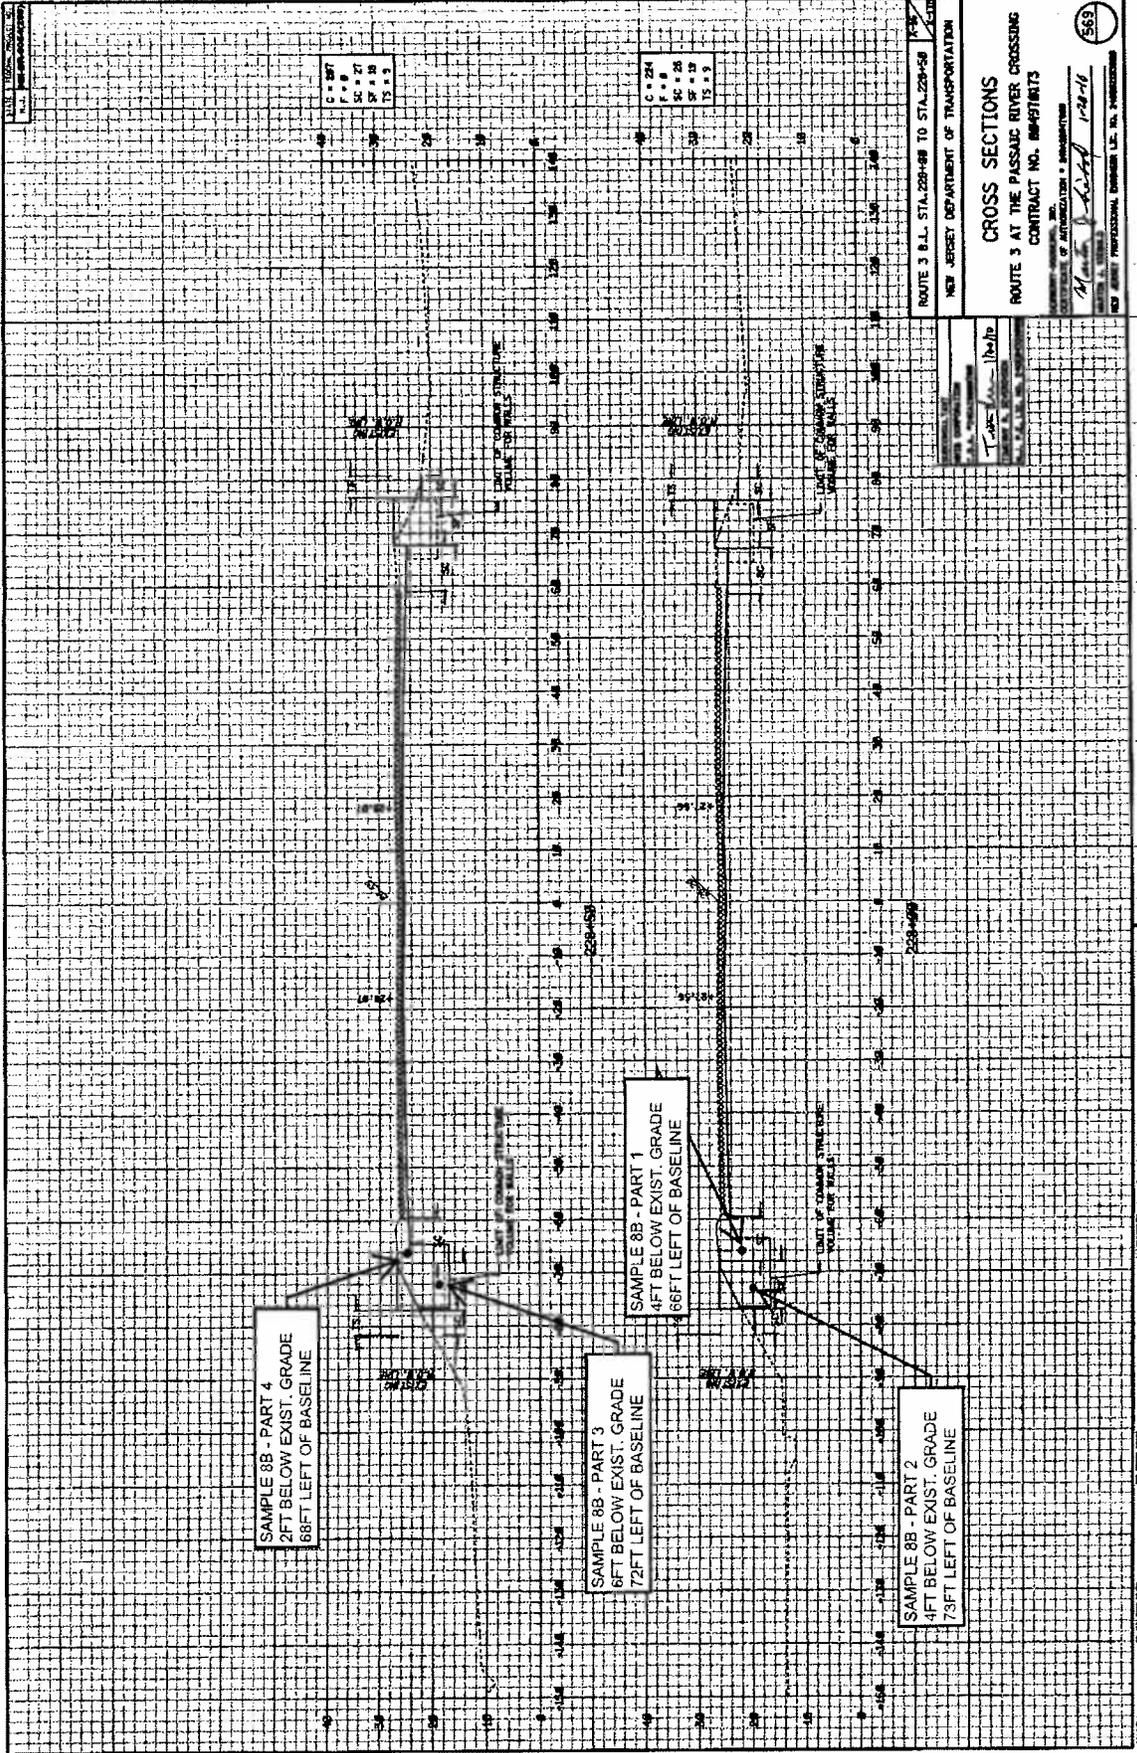

ROUTE 3 B.L. STA. 228+88 TO STA. 228+50
 NEW JERSEY DEPARTMENT OF TRANSPORTATION
CROSS SECTIONS
 ROUTE 3 AT THE PASSAIC RIVER CROSSING
 CONTRACT NO. 86-4918(1)3
 DATE: 11/28/86
 DRAWN BY: [Signature]
 CHECKED BY: [Signature]
 569

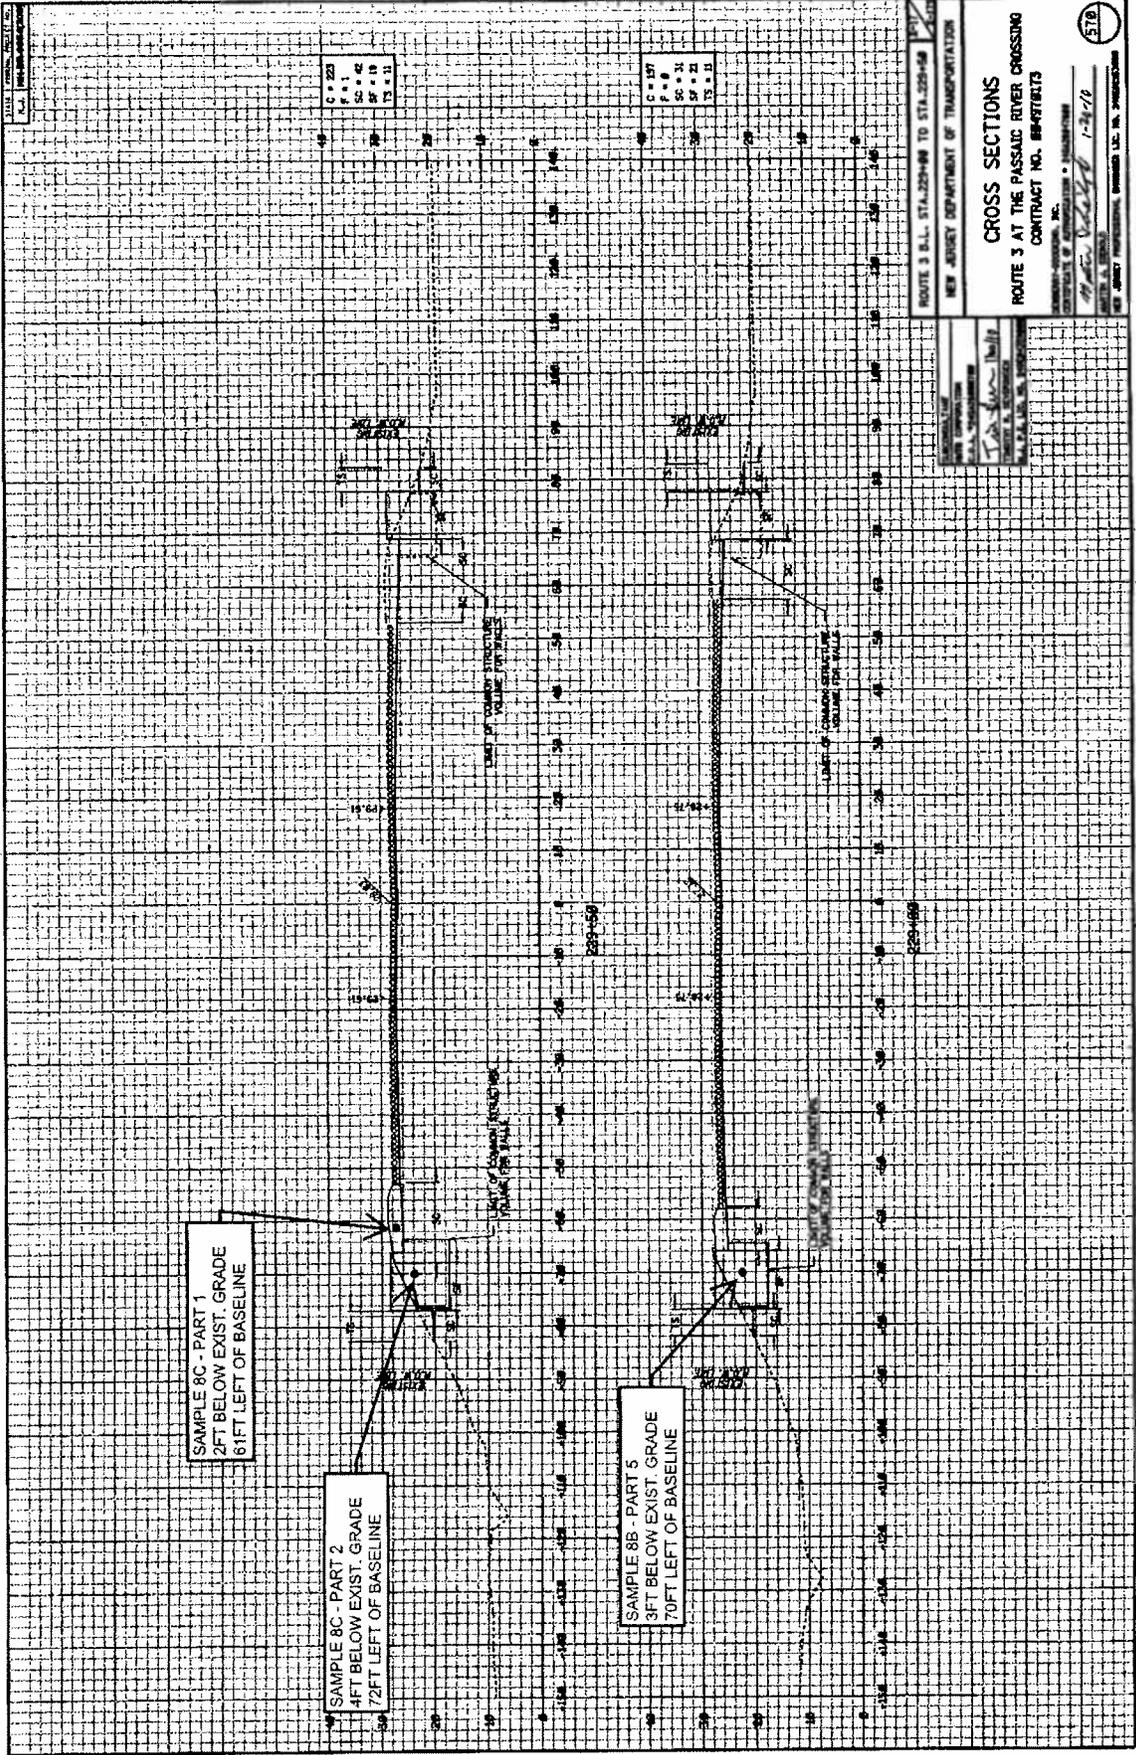


ROUTE 3 S.L. STA. 229+00 TO STA. 229+50
 NEW JERSEY DEPARTMENT OF TRANSPORTATION
CROSS SECTIONS
 ROUTE 3 AT THE PASSAIC RIVER CROSSING
 CONTRACT NO. BR476713
 578

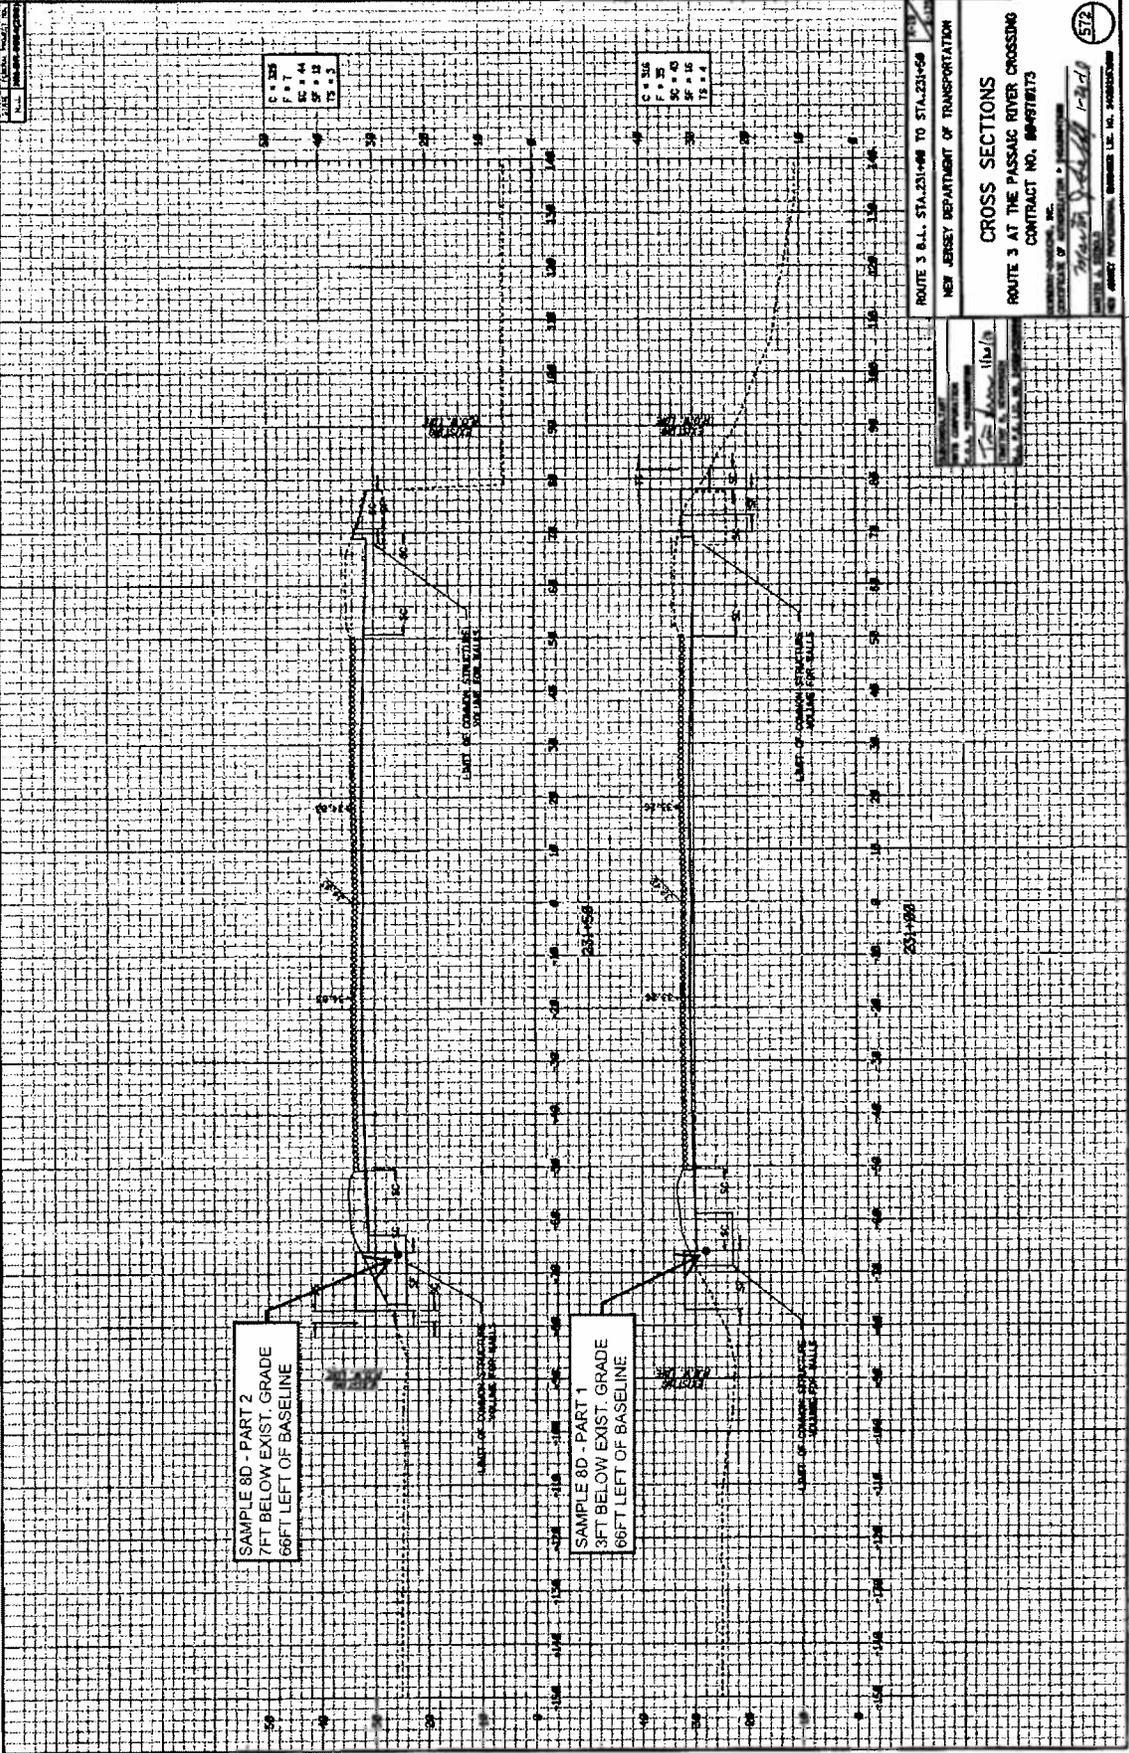

ROUTE 3 B.L. STA. 231+00 TO STA. 231+50
 NEW JERSEY DEPARTMENT OF TRANSPORTATION
CROSS SECTIONS
 ROUTE 3 AT THE PASSAIC RIVER CROSSING
 CONTRACT NO. 99A078173

DESIGNED BY: [Signature]
 CHECKED BY: [Signature]
 DATE: 1-2-01

STATE OF NEW JERSEY
 DEPARTMENT OF TRANSPORTATION
 572

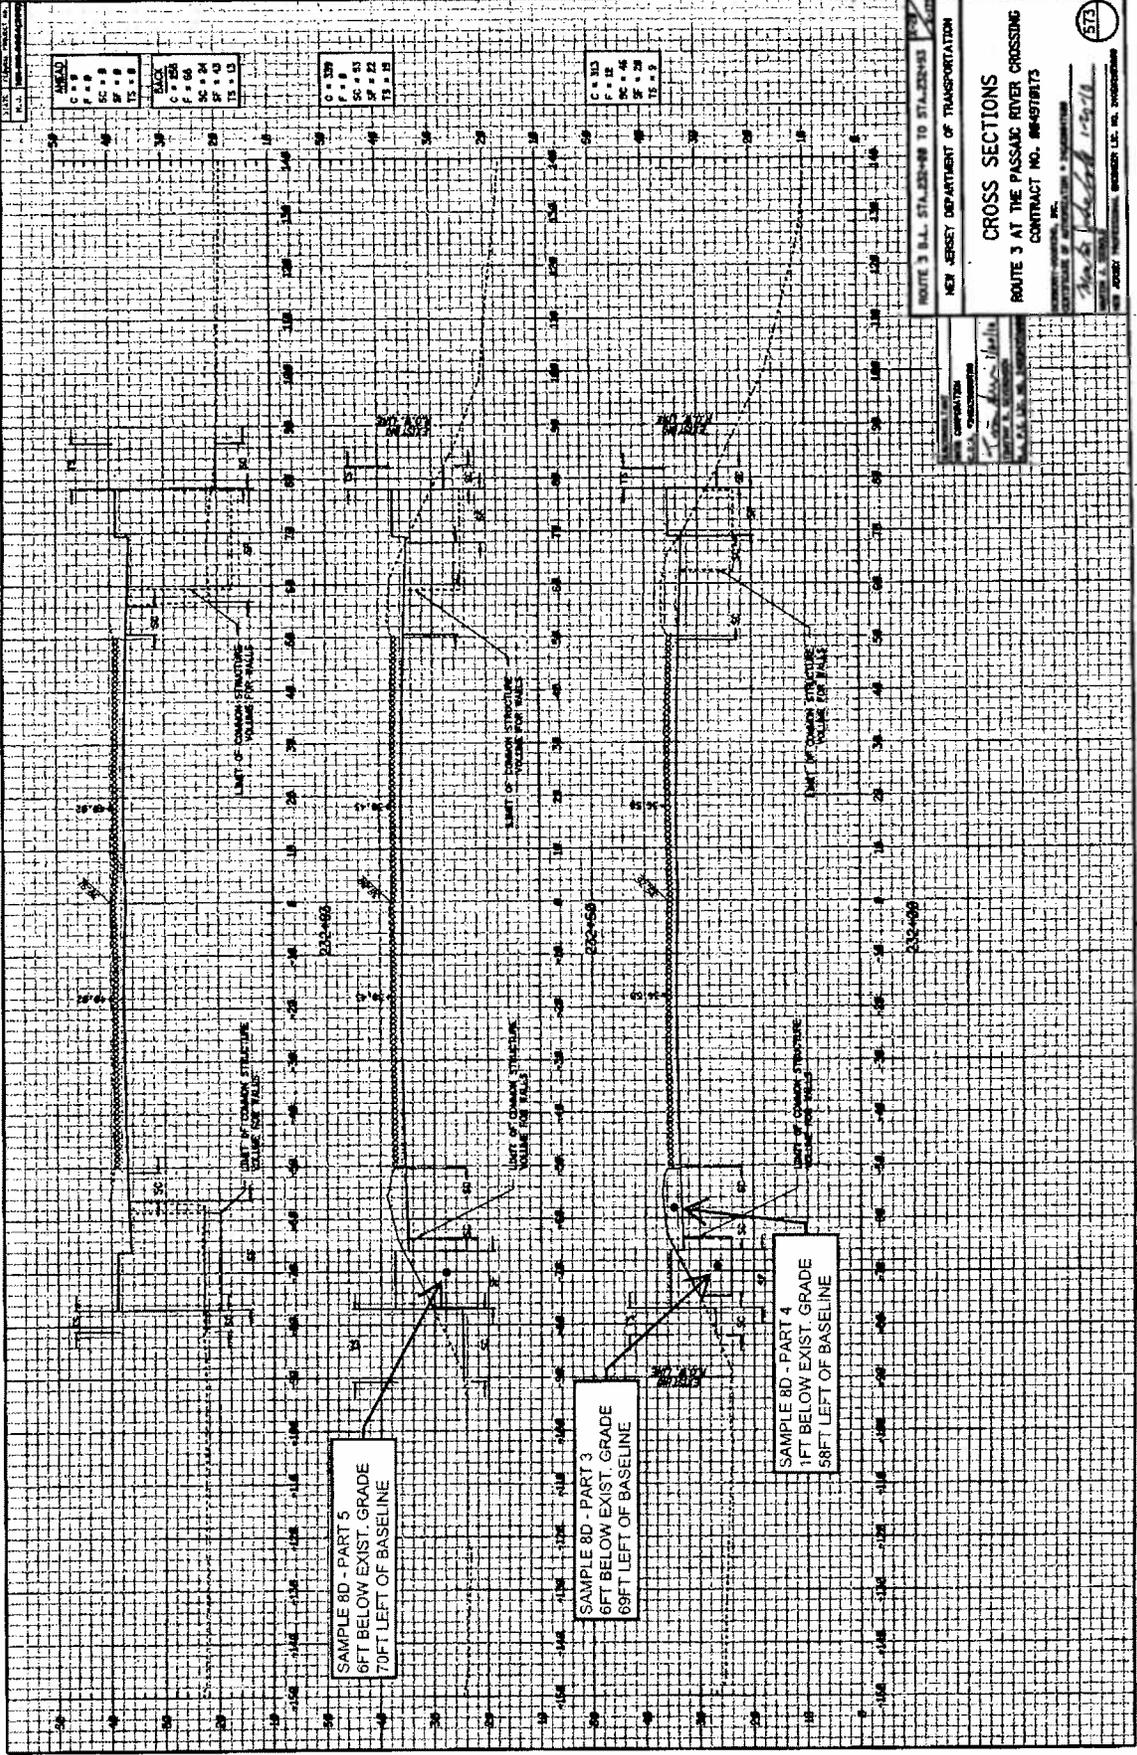

ANALYSIS	
C	0.0
F	0.0
S	0.0
T	0.0
U	0.0

BACK	
C	0.0
F	0.0
S	0.0
T	0.0
U	0.0

C	
0	0.0
F	0.0
S	0.0
T	0.0
U	0.0

C	
0	0.0
F	0.0
S	0.0
T	0.0
U	0.0

ROUTE 3 B.L. STA. 23+00 TO STA. 23+15
 NEW JERSEY DEPARTMENT OF TRANSPORTATION
CROSS SECTIONS
 ROUTE 3 AT THE PASSAIC RIVER CROSSING
 CONTRACT NO. 86-4378(173)




573

PROJECT NO.	1192
STRUCTURE NO.	RETAINING WALL NO. 13


SAMPLING NOTES:

1. ONE 5-PART COMPOSITE SAMPLE WILL BE TAKEN FROM WALL NO. 13 COMMON STRUCTURE VOLUME. EQUATING TO APPROXIMATELY ONE 5-PART COMPOSITE PER 975 CY.
2. SAMPLING TO BE PERFORMED BY AQUA-PRO TECH LABORATORIES FIELD TECH.
3. SAMPLING TECHNICIAN SHALL USE A STAINLESS STEEL SAMPLING SPATULA THAT WILL BE DECONTAMINATED BEFORE SAMPLING AND IN BETWEEN SAMPLING AT EACH COMPOSITE AREA OR USE DURABLE TEFLON SPATULAS.
4. MATERIAL WILL BE EXCAVATED VIA AN EXCAVATOR - PC400 OR SIMILAR. SAMPLES WILL BE TAKEN WITHIN THE EXCAVATOR'S BUCKET IN ACCORDANCE WITH NOTE #2.
5. SEE ATTACHED CROSS-SECTIONS FOR DETAILED LOCATIONS OF EACH SAMPLE.

**EXCESS SOIL SAMPLING PLAN #9
ABOUT 975 CY OR 1450 TONS**

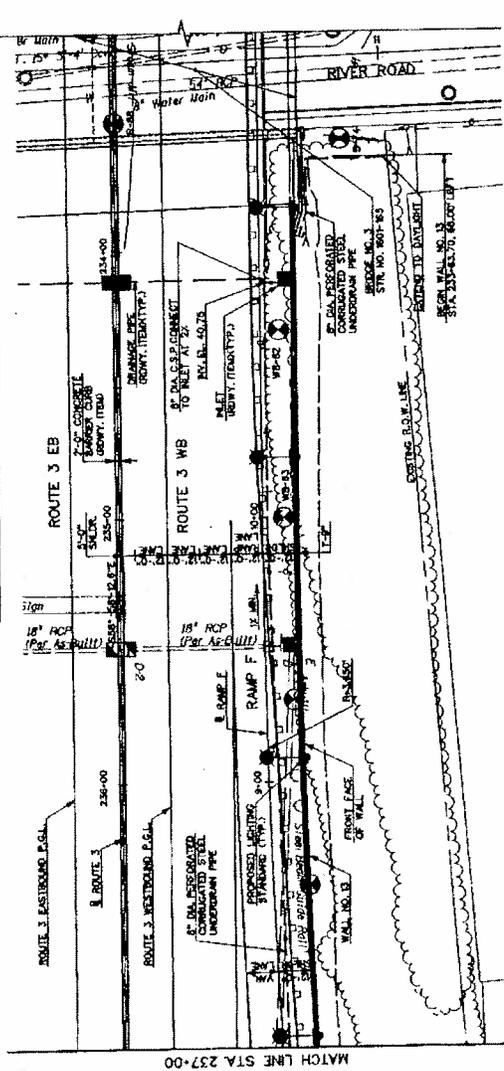

PLAN
SCALE: P = 20'-0"

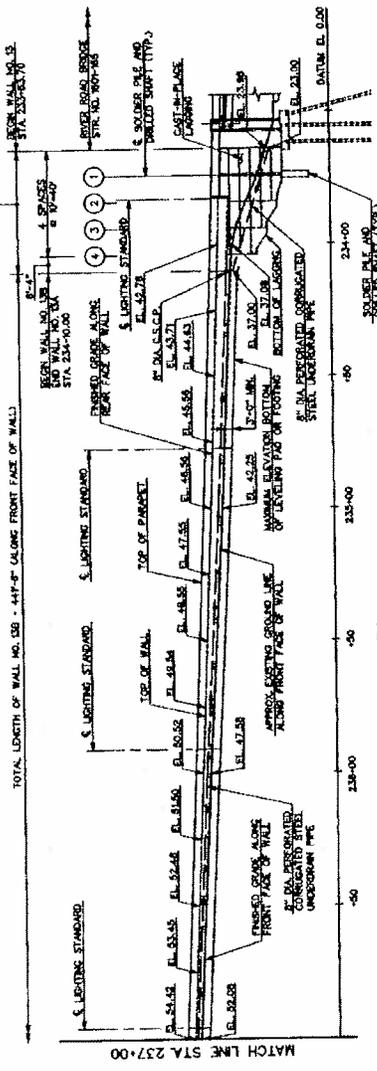

ELEVATION
SCALE: P = 20'-0"

LEGEND:
 (1) DIRECTION OF TRAFFIC
 (2) SOLIDER FILE NUMBER

DATE	NO.	BY	DESCRIPTION

DATE: 11/28/19
 DRAWN BY: S. WILSON
 CHECKED BY: S. WILSON
 SCALE: AS SHOWN



PROJECT NO. 1192
 SHEET NO. 2-107

DATE: 11/28/19
 DRAWN BY: S. WILSON
 CHECKED BY: S. WILSON
 SCALE: AS SHOWN

PROJECT NO. 1192
 SHEET NO. 2-107

PROJECT / DESIGN / DRAWING NO.	1133
DATE	11/14/80
STRUCTURE NO.	RETAINING WALL NO. 13
STRUCTURE NAME	

SAMPLING NOTES:

- ONE 5-PART COMPOSITE SAMPLE WILL BE TAKEN FROM WALL NO. 13 COMMON STRUCTURE VOLUME. EQUATING TO APPROXIMATELY ONE 5-PART COMPOSITE PER 975 CY.
- SAMPLING TO BE PERFORMED BY AQUA-PRO TECH LABORATORIES FIELD TECH.
- SAMPLING TECHNICIAN SHALL USE A STAINLESS STEEL SAMPLING SPATULA THAT WILL BE DECONTAMINATED BEFORE SAMPLING AND IN-BETWEEN SAMPLING AT EACH COMPOSITE AREA OR USE DURABLE TEFLO SPATULAS.
- MATERIAL WILL BE EXCAVATED VIA AN EXCAVATOR, APC-90 OR SIMILAR. SAMPLING TECHNICIAN WILL THEN TAKE A SAMPLE FROM THE MATERIAL WITHIN THE EXCAVATOR'S BUCKET IN ACCORDANCE WITH NOTE #3.
- SEE ATTACHED CROSS-SECTIONS FOR DETAILED LOCATIONS OF EACH SAMPLE.

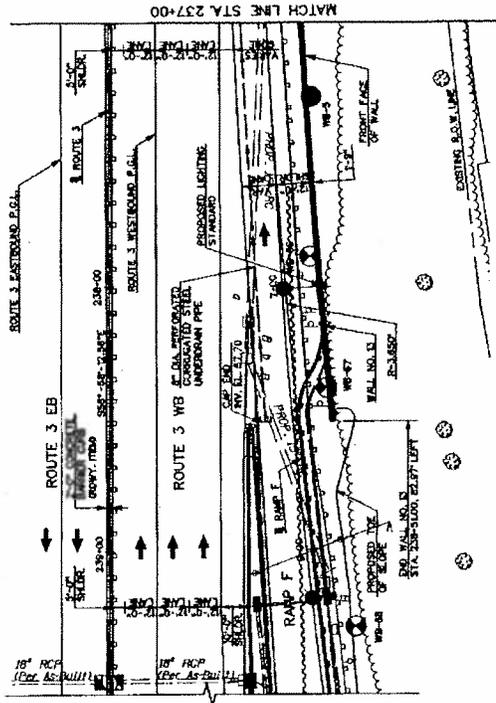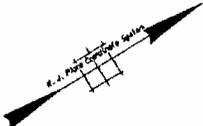

PLAN
SCALE 1" = 20'-0"

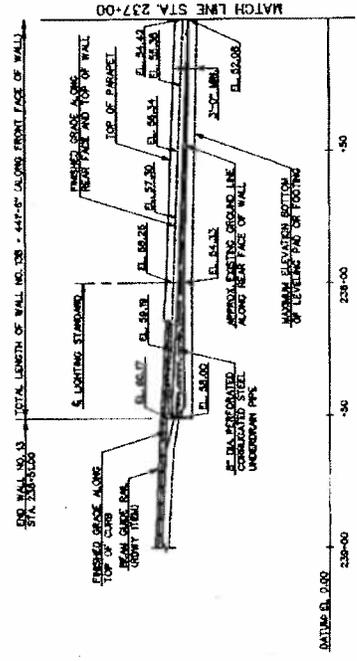


ELEVATION
SCALE 1" = 20'-0"

WALL NO. 13
NEW JERSEY DEPARTMENT OF TRANSPORTATION
BUREAU OF STRUCTURAL ENGINEERING
GENERAL PLAN AND ELEVATION II
ROUTE 3 AT THE PASSAIC RIVER CROSSING
CLIFTON CITY BOROUGH
PASSAIC COUNTY
CONTRACT NO. 00497073

DESIGNED BY	DATE	SCALE
CHECKED BY		
APPROVED BY		
IN CHARGE OF		

REVISION	NO.	DATE	DESCRIPTION



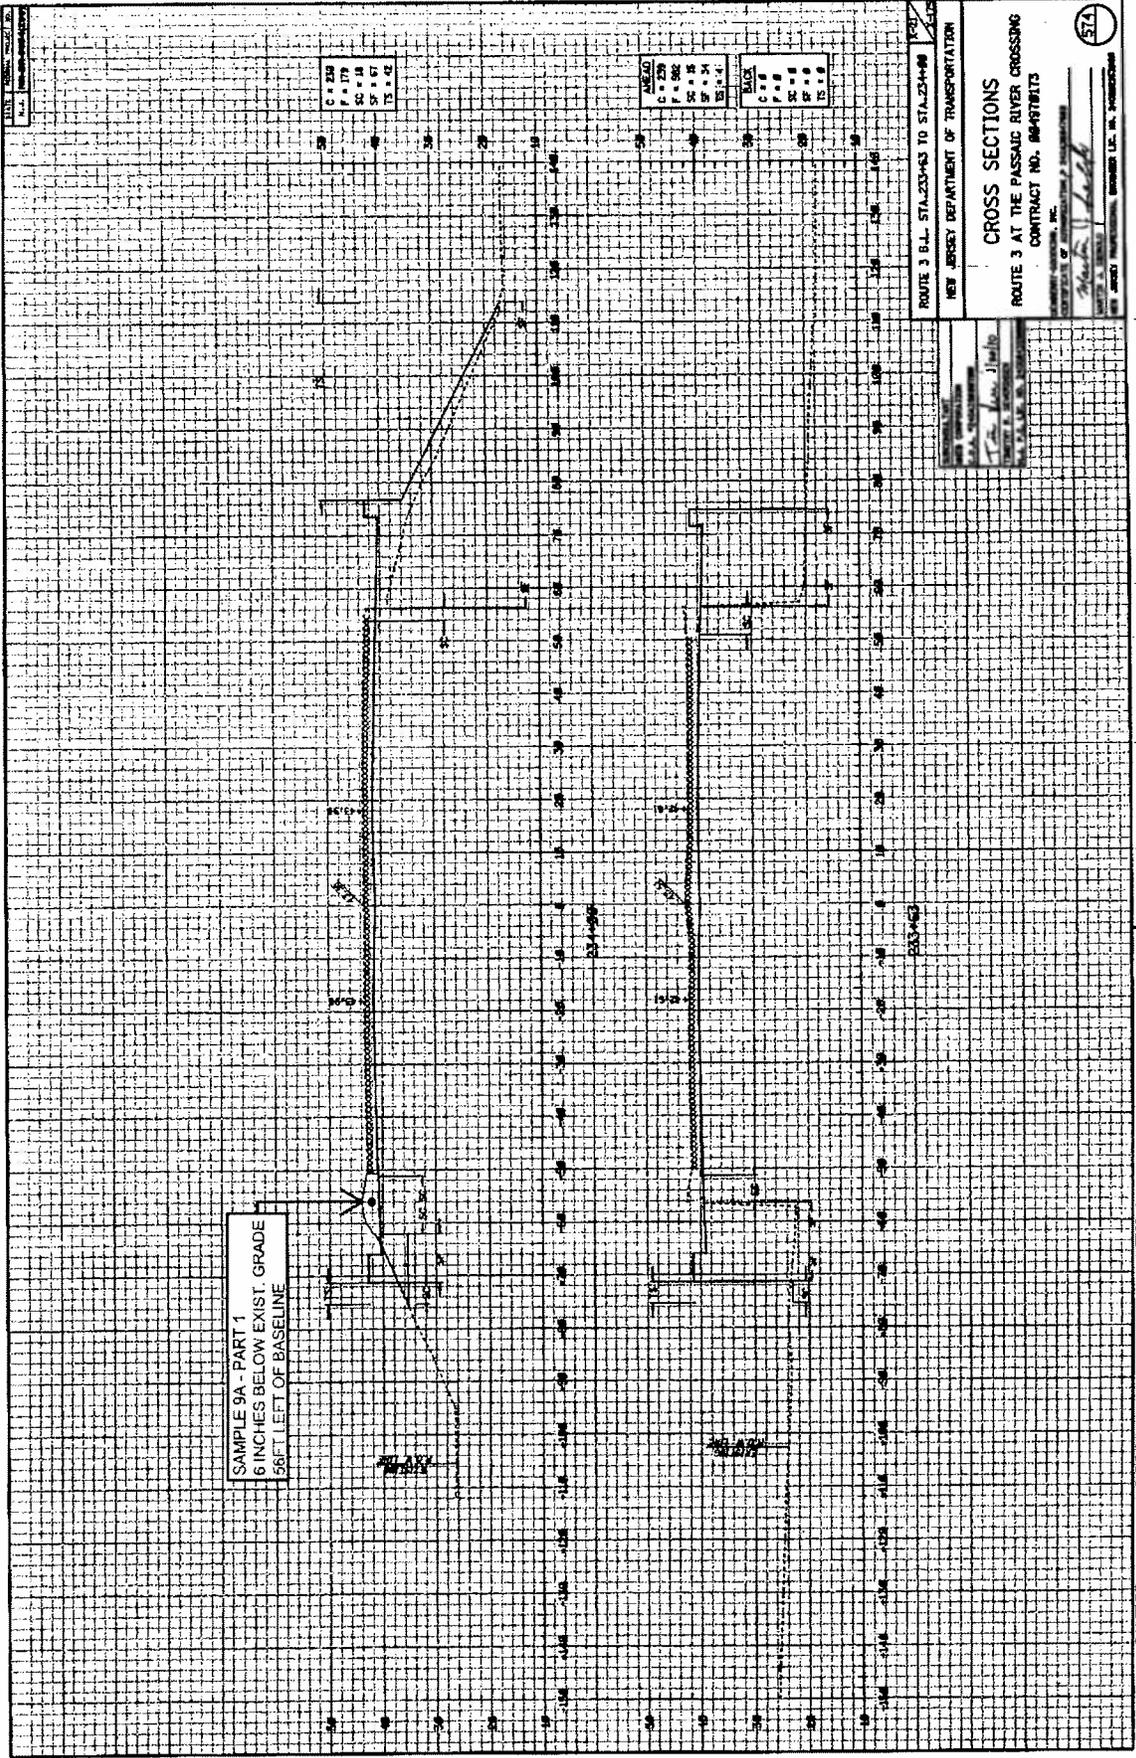


SAMPLE 9A - PART 1
 6 INCHES BELOW EXIST. GRADE
 56 FT LEFT OF BASELINE

ASBUILT	
C	2.54
F	17.18
SC	1.18
SP	1.67
TS	4.42

ASBUILT	
C	2.59
F	18.62
SC	1.35
SP	1.74
TS	4.41

PROPOSED	
C	2.54
F	17.18
SC	1.18
SP	1.67
TS	4.42

ROUTE 3 S.L. STATIONING TO STA 23+48.88
 NEW JERSEY DEPARTMENT OF TRANSPORTATION
CROSS SECTIONS
 ROUTE 3 AT THE PASSAIC RIVER CROSSING
 CONTRACT NO. 84P878173
 DEWBERRY-GOODKIND, INC.
 100 JERSEY TURNPIKE, SUITE 100, HOBOKEN, N.J. 07030

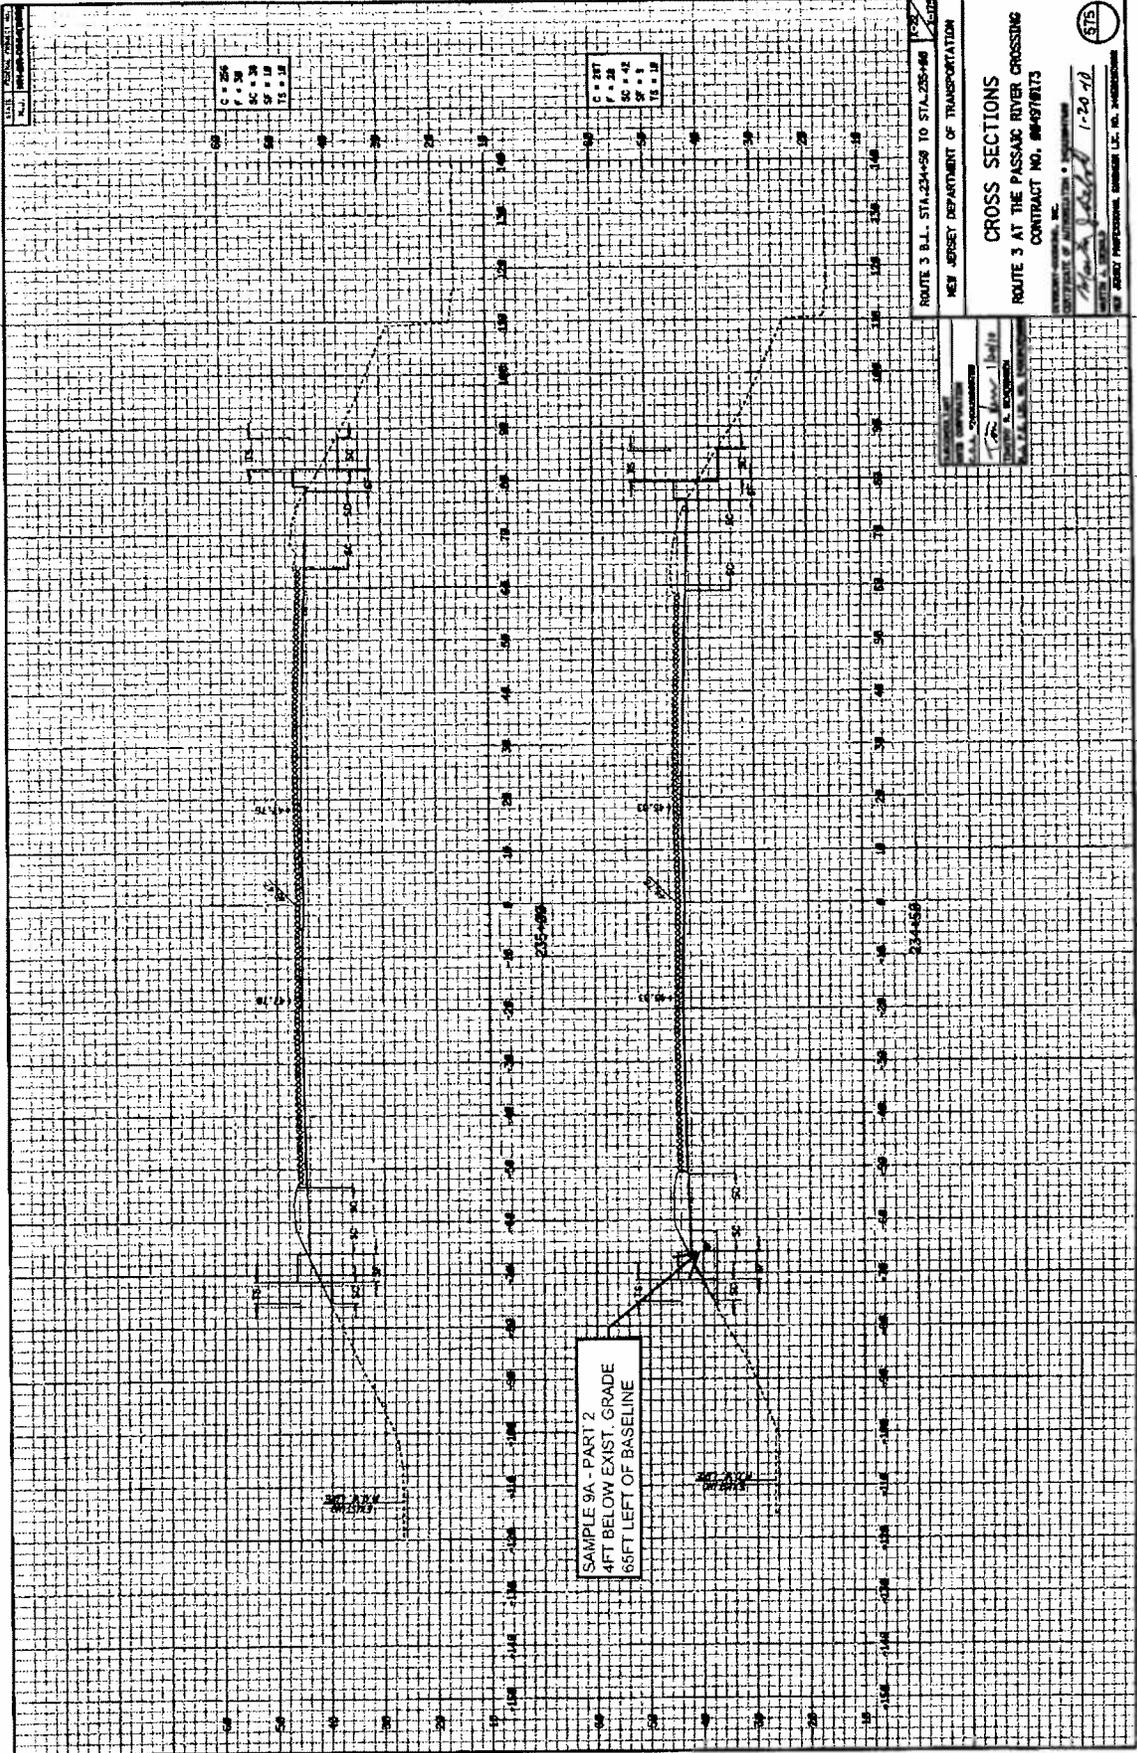


C = 25
 F = 28
 SC = 42
 SF = 1
 VS = 12

C = 37
 F = 28
 SC = 42
 SF = 1
 VS = 12

SAMPLE 9A - PART 2
 4FT BELOW EXIST. GRADE
 65FT LEFT OF BASELINE

ROUTE 3 B.L. STA. 234+50 TO STA. 235+40
 NEW JERSEY DEPARTMENT OF TRANSPORTATION
CROSS SECTIONS
 ROUTE 3 AT THE PASSADOC RIVER CROSSING
 CONTRACT NO. 88-4578173
 CONTRACT DATE 1-20-70
 NEW JERSEY PROFESSIONAL ENGINEER L.C. NO. 240200000000



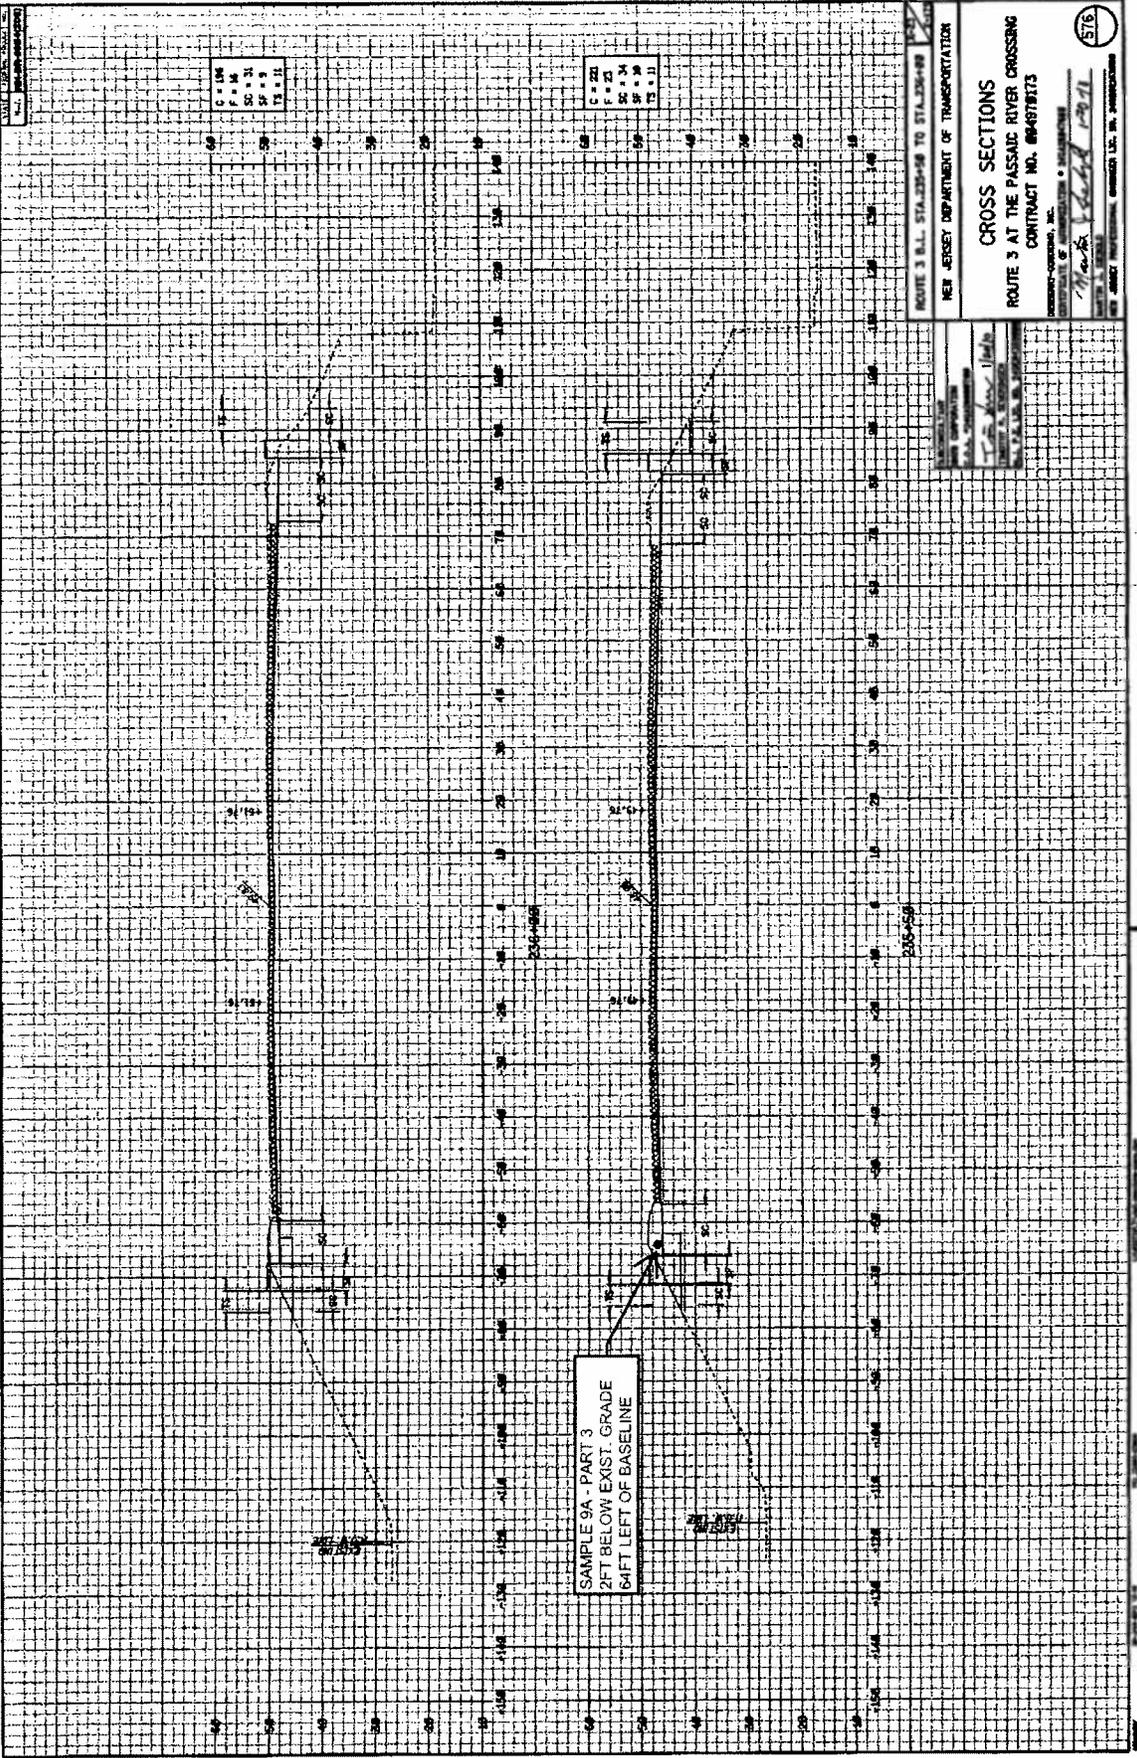


C	1.00
F	1.00
S	1.00
T	1.00

C	1.00
F	1.00
S	1.00
T	1.00

NEW JERSEY DEPARTMENT OF TRANSPORTATION
 ROUTE 3 B.L. STA. 226+58 TO STA. 226+98
CROSS SECTIONS
 ROUTE 3 AT THE PASSAIC RIVER CROSSING
 CONTRACT NO. 664978173
 DESIGNER: GEORGE W. BROWN & ASSOCIATES
 12/20/11
 NEW JERSEY PROFESSIONAL ENGINEERS ASSOCIATION, INC. 516


Prepared by: _____
 Checked by: _____
 Approved by: _____
 Date: _____
 Desberry-Geedink, Inc. 66000000, N.J.

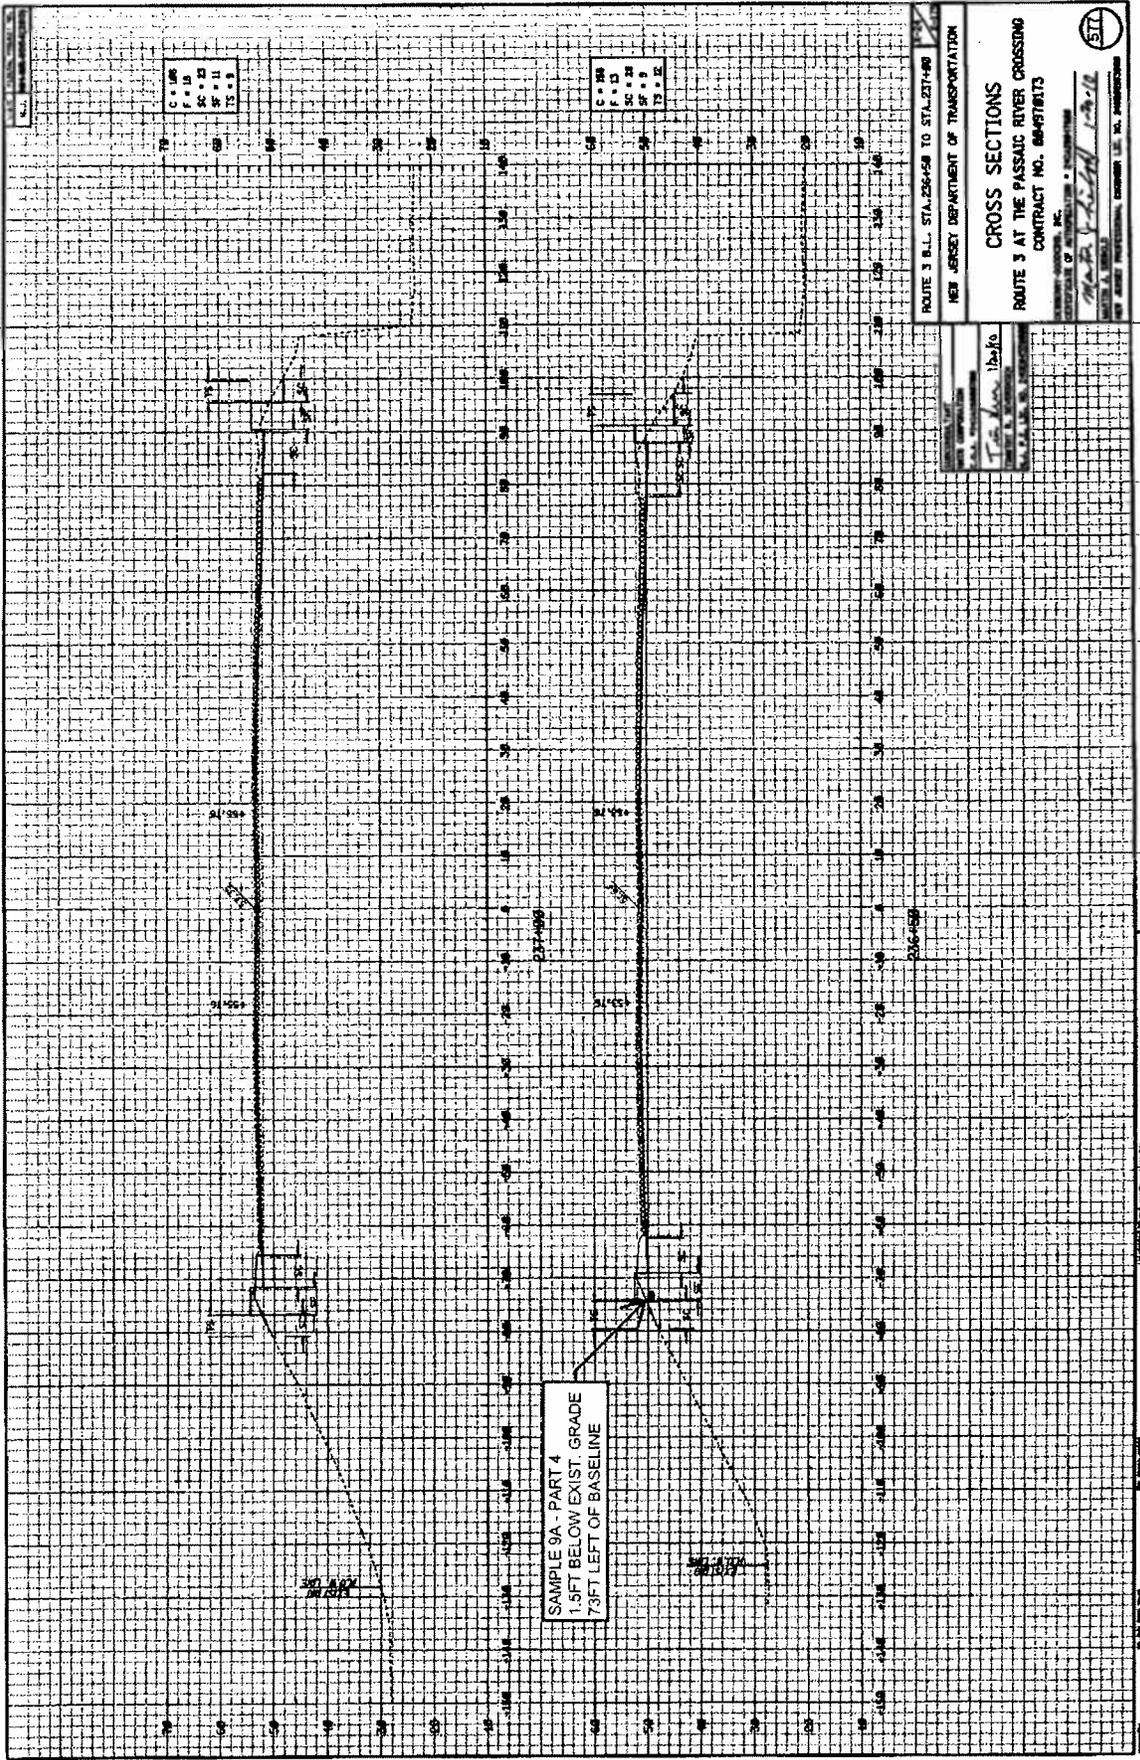

ROUTE 3 B.L. STA. 256+58 TO STA. 274+90
 NEW JERSEY DEPARTMENT OF TRANSPORTATION
CROSS SECTIONS
 ROUTE 3 AT THE PASSAIC RIVER CROSSING
 CONTRACT NO. 66A-970173
 STATE OF NEW JERSEY
 DEPARTMENT OF TRANSPORTATION
 CONTRACT NO. 66A-970173
 DATE: 1/15/83
 BY: [Signature]
 CHECKED BY: [Signature]



In Name of
 Drawn by
 Checked by
 Approved by
 Date
 Bloomfield, N.J.
 Dewberry-Goodkind, Inc.

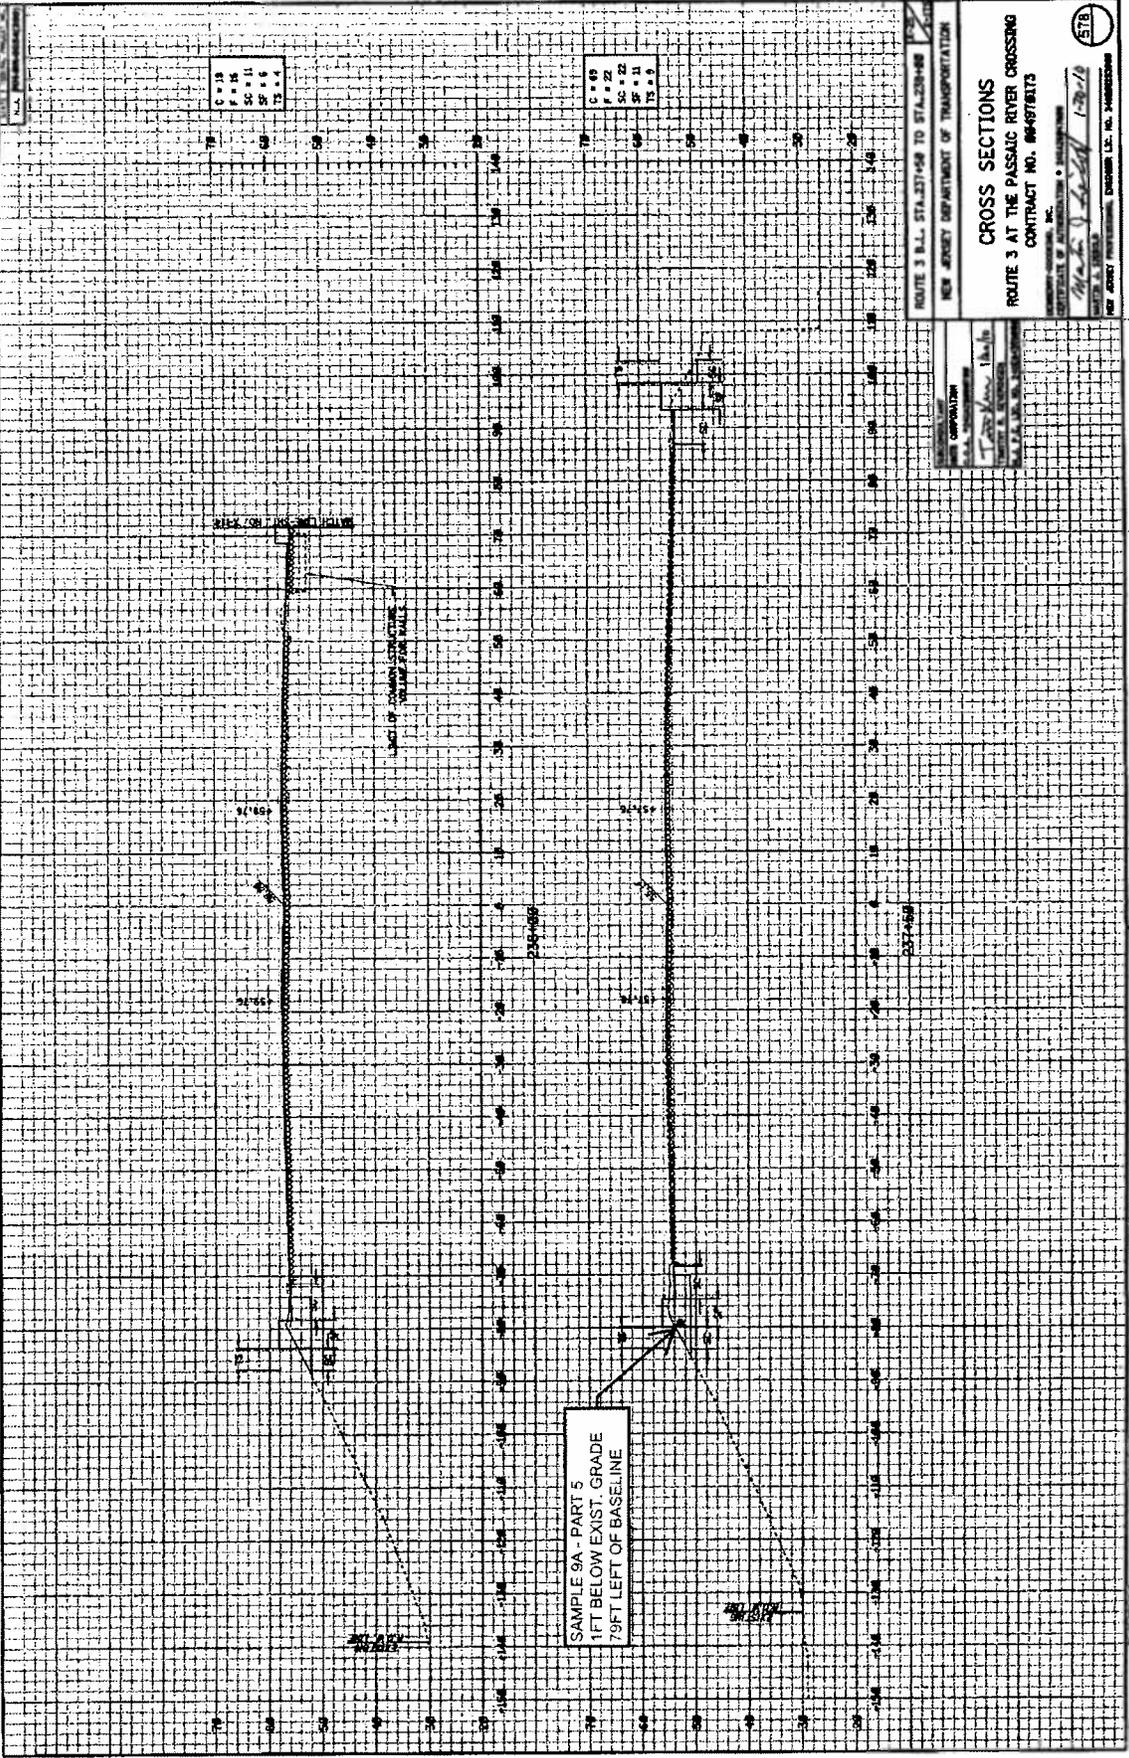

NEW JERSEY DEPARTMENT OF TRANSPORTATION
 ROUTE 3 B.L. STA. 271+48 TO STA. 281+48
CROSS SECTIONS
 ROUTE 3 AT THE PASSAIC RIVER CROSSING
 CONTRACT NO. 66-4978173

DESIGNED BY: [Signature]
 DATE: 1-28-10

NEW JERSEY PROFESSIONAL ENGINEER LICENSE NO. 340822000000

APL

AQUA PRO-TECH LABORATORIES

www.aquaprotechlabs.com

1275 BLOOMFIELD AVENUE • BUILDING 6
FAIRFIELD, NEW JERSEY 07004

TEL: 973.227.0422
FAX: 973.227.2813

CONTAMINATION LEVEL

HIGH MEDIUM LOW

CHAIN OF CUSTODY

CLIENT: Fletcher Cremer
 ADDRESS: 101 E. Broadway
Hackensack, NJ 07601
 PHONE: 201-984-7309
 E-MAIL: pc@aquaprotech.com
 PROJECT NAME: West Clean
 PROJECT MGR: Pet Capran
 PROJECT OR PO #:

SEND REPORT TO:
 ADDRESS:
 PHONE:
 FAX:
 SEND INVOICE TO:
 ADDRESS:
 SAMPLED BY: JG

PAGE 4 OF 4

TURN-AROUND TIME

APL STANDARD 2 weeks

RUSH (choose one below)

24 hr. (date & time required)

48 hr. (date & time required)

72 hr. (date & time required)

1 week

2 weeks

REPORT FORMAT 1/10/12

RESULTS ONLY

NJ DEP REDUCED

NJ DEP FULL

STATE FORMS/2 REPORTING

PHYSION

ELECTRONIC FORMAT

EMAIL DELIVERY

HARDSITE END

EXCEL

SRP#

MATRIX ABBREVIATIONS: D - DRINKING WATER G - GROUNDWATER W - WASTEWATER S - SOIL SL - SLUDGE C - CONCRETE L - LAKE

APL Lab ID#	Sample Source: Field ID	Date	Time	Sample Type		No. of bottles	Preservative	Analysis Requested
				✓	✓			
12070509-001	9A	7/16/12	7:50 ^{AM}	X	S	1		TCL/TAL+30, EPH 2
002	8D		8:23	X		1		
003	8C		8:59	X		1		
004	8B		9:28	X		1		
005	8A		9:51	X		1		
006	6A		10:29	X		1		
007	6B		11:00	X		1		
008	A		11:45	X		1		
009	B		12:20	X		1		

RELINQUISHED BY (Print) _____
 Signature _____

RECEIVED BY (Print) John Gonzalez
 Signature _____

RELINQUISHED BY (Print) _____
 Signature _____

RECEIVED BY (Print) _____
 Signature _____

RELINQUISHED BY (Print) _____
 Signature _____

RECEIVED BY (Print) _____
 Signature _____

DATE 7/16/12 Time 1:00 PM

DATE 7/16/12 Time 1:45 PM

DATE _____ Time _____

COMMENTS/SPECIAL INSTRUCTIONS

Cooler Temp. upon receipt at lab

CERTIFICATIONS: NELAP (National Environmental Laboratory Accreditation Program) NJDEP #07010 PADEP #68-02903 NYDOH #11634 CTPH #0233 US-ARMY
 By signing this Chain of Custody Agreement, customer expressly agrees to pay APL for all charges, reasonably incurred in connection with analysis and reporting for these samples

APL

AQUA PRO-TECH LABORATORIES
www.aquaprotechlabs.com

1275 BLOOMFIELD AVENUE • BUILDING 6
FAIRFIELD, NEW JERSEY 07004

TEL: 973-227-0422
FAX: 973-227-2813

CONTAMINATION LEVEL

HIGH MEDIUM LOW

CHAIN OF CUSTODY

CLIENT: **Fletcher CHAMBERLAIN**

ADDRESS: **101 EAST BROADWAY**

PHONE: **HAKENSACK, NJ 07601**

PHONE: **973-954-1209**

E-MAIL: **pramono@henson.com**

PROJECT NAME: **3 WEST CANTON**

ADDRESS: **3 WEST CANTON**

SEND INVOICE TO:

PROJECT or PO #:

SAMPLED BY: **JP**

PAGE **2** OF **4**

TURN-AROUND TIME

- APL STANDARD 2 weeks
- RUSH (choose one below)
 - 24 hr. date & time required
 - 48 hr. date & time required
 - 72 hr. date & time required
 - 7 week **7/20/12**

- REPORT FORMAT
- RESULTS ONLY
 - NJ DEP REDUCED
 - NJ DEP FULL
 - STATE FORMS/FE REPORTING
 - PWS/DF
- ELECTRONIC FORMAT
- EMAIL DELIVERY
 - HARDSITE EDD
 - EXCEL
 - SHP

MATRIX ABBREVIATIONS: D - DRINKING WATER G - GROUNDWATER W - WASTEWATER S - SOIL SL - SLUDGE C - CONCRETE L - LAKE

APL Lab ID#	Sample Source: Field ID	Date	Time	Sample Type		No. of Bottles	Preservative	Analysis Requested
				1	2			
12070509-010	C	7/16/12	10:25	X	S	1	NONE	TEL/TAL +30, EPA2
110	D	7/12/12		Y	S	1	NONE	

RELINQUISHED BY (Print) _____ DATE **7/16/12** RECEIVED BY (Print) **John Gonzalez**

Signature _____ Time **1:00 PM** Signature _____

RELINQUISHED BY (Print) **John Gonzalez** DATE **7/16/12** RECEIVED BY (Print) _____

Signature **John Gonzalez** Time **1:05 PM** Signature _____

RELINQUISHED BY (Print) _____ DATE _____ RECEIVED BY (Print) _____

Signature _____ Time _____ Signature _____

COMMENTS/SPECIAL INSTRUCTIONS

Cooler Temp. upon receipt at lab _____

CERTIFICATIONS: NELAP (National Environmental Laboratory Accreditation Program) NJDEP #07010 PADDP #88-02903 ARDOL #11634 CIBL #0233 US ARMY

By signing this Chain of Custody Agreement, customer expressly agrees to pay APL for all charges, reasonably incurred in connection with analysis and reporting for these samples

AQUA PRO-TECH LABORATORIES
 www.aquaprotechlabs.com
 1275 BLOOMFIELD AVENUE • BUILDING 6
 FAIRFIELD, NEW JERSEY 07004
 TEL: 973.227.0422
 FAX: 973.227.2813

CONTAMINATION LEVEL
 HIGH MEDIUM LOW

CLIENT: J. Fletcher Cremer

ADDRESS: 101 E. Broadway

PHONE: Hackensack NJ 07601

E-MAIL: 201-954-7309

PROJECT NAME: 113 West Clinton

PROJECT MGR: JOE CAHILL

PROJECT or PO #: _____

SEND REPORT TO:

ADDRESS:

PHONE:

FAX:

SEND INVOICE TO:

ADDRESS:

SAMPLED BY: JG

TURN-AROUND TIME
 APL STANDARD 2 weeks
 RUSH (choose one below)
 24 hr. date & time required
 48 hr. date & time required
 72 hr. date & time required
 1 week
7/20/12
REPORT FORMAT
 RESULTS ONLY
 NJ DEP REDUCED DELIVERABLES
 NJ DEP FULL DELIVERABLES
 ELECTRONIC DATA DELIVERY
 SRP#
 STATE FORMS/EZ REPORTING

MATRIX ABBREVIATIONS: D - DRINKING WATER G - GROUNDWATER W - WASTEWATER S - SOIL SL - SLUDGE C - CONCRETE L - LAKE

APL Lab ID#	Sample Source: Field ID	Date	Time	Sample Type		No. of Section	Preservative	Analysis Requested
				S	L			
10070609-012	9A G-20	7/16/12	7:50 AM	S		1	None	Discrete 10+10
013	8D		8:25 AM					
014	8C		8:59 AM					
015	8B		9:28 AM					
016	8A		9:51 AM					
017	6A		10:29 AM					
018	6B		11:00 AM					
019	A		11:45 AM					
020	B		12:20 PM					

RELINQUISHED BY (Print) _____ RECEIVED BY (Print) John Gonzalez
 Signature _____ Signature _____
 RELINQUISHED BY (Print) John Gonzalez RECEIVED BY (Print) _____
 Signature _____ Signature _____
 RELINQUISHED BY (Print) _____ RECEIVED BY (Print) _____
 Signature _____ Signature _____
 COMMENTS/SPECIAL INSTRUCTIONS _____
 Cooler Temp. upon receipt at lab _____

AQUA PRO-TECH LABORATORIES
www.aquaprotechlabs.com

1275 BLOOMFIELD AVENUE • BUILDING 6
FAIRFIELD, NEW JERSEY 07004

TEL: 973.227.0422
FAX: 973.227.2813

CONTAMINATION LEVEL

HIGH MEDIUM LOW

MATRIX ABBREVIATIONS: D - DRINKING WATER G - GROUNDWATER W - WASTEWATER S - SOIL SL - SLUDGE C - CONCRETE L - LAKE

CLIENT: J. Fletcher Creamer
 ADDRESS: 101 E. Broadway
Hackensack NJ 07601
 PHONE: 201-954-7309
 E-MAIL: _____
 PROJECT NAME: R.S. Clifton
 PROJECT MGR: Pat Cannon
 PROJECT or PO #: _____

SEND REPORT TO: _____
 ADDRESS: _____
 PHONE: _____
 FAX: _____

SEND INVOICE TO: _____
 ADDRESS: _____
 SAMPLED BY: JG

TURN-AROUND TIME

APL STANDARD 2 weeks
 RUSH (choose one below)
 24 hr. data & time required
 48 hr. data & time required
 72 hr. data & time required
 1 week 7/20/12

REPORT FORMAT: _____
 ELECTRONIC FORMAT: _____
 RESULTS ONLY
 NJ DEP REDUCED
 NJ DEP FULL
 STATE FORMS/EZ REPORTING
 PWSID# _____
 EMAIL DELIVERY
 HAZSITE EDO
 EDCB
 SRP# _____

APL Lab ID#	Sample Source: Field ID	Date	Time	Sample Type		No. of Batches	Preservative	Analysis Requested
				A	B			
12070009-021	C Gas	7/16/12	12:25	✓	✓	8	None	Discrete 10+10
of 022	D I	7/16/12	12:02	✓	✓			

RELINQUISHED BY (Print) _____
 Signature John Gonzalez

RECEIVED BY (Print) _____
 Signature John Gonzalez

DATE: 7/16/12 Time: 1:00 PM

RELINQUISHED BY (Print) _____
 Signature John Gonzalez

RECEIVED BY (Print) _____
 Signature John Gonzalez

DATE: 7/16/12 Time: 1:45 PM

RELINQUISHED BY (Print) _____
 Signature _____

RECEIVED BY (Print) _____
 Signature _____

DATE: _____ Time: _____

COMMENTS/SPECIAL INSTRUCTIONS

Cooler Temp. upon receipt at lab: _____

CERTIFICATIONS: NELAP (National Environmental Laboratory Accreditation Program) NJDEP #07010 PADep #68-02903 NYDOH #11634 CTEH #0233 U.S. ARMY
 By signing this Chain of Custody Agreement, customer expressly agrees to pay APL for all charges, reasonably incurred in connection with analysis and reporting for these samples

~~DATE~~ TINES SAMPLES WERE TAKEN

1/16/12

~~1~~
 1 7:50 AM
 2 7:56 AM
 3 7:59 AM
 4 8:02 AM
 5 8:07 AM

Well 13
 9A

9A

6 8:23 AM
 7 8:28 AM
 8 8:33 AM
 9 8:40 AM
 10 8:45 AM

8D

11 8:59 AM
 12 9:10 AM
 13 9:12 AM
 14 9:18 AM
 15 9:21 AM

8C

16 9:28 AM
 17 9:35 AM
 18 9:37 AM
 19 9:43 AM
 20 9:45 AM

8B

21 9:51 AM
 22 9:53 AM
 23 9:57 AM
 24 10:02 AM
 25 10:04 AM

8A

26 10:24 AM
 27 10:32 AM
 28 10:41 AM
 29 10:43 AM
 30 10:52 AM

Le-1A

31 11:00 AM
 32 11:07 AM
 33 11:09 AM
 34 11:16 AM
 35 11:22 AM

Le-1B

36 11:45 AM
 37 11:49 AM
 38 11:51 AM
 39 11:54 AM
 40 11:57 AM

A#

41 12:02 PM 5
 42 12:04 PM 4
 43 12:07 PM 3
 44 12:10 PM 2
 45 12:14 PM 1

D

46 12:20 PM
 47 12:30 PM
 48 12:38 PM
 49 12:37 PM
 50 12:42 PM

B

51 12:25 PM
52 12:27 PM
53 12:40
54 12:45
55 12:47